


T. 17 S., R. 9 W., W.M.

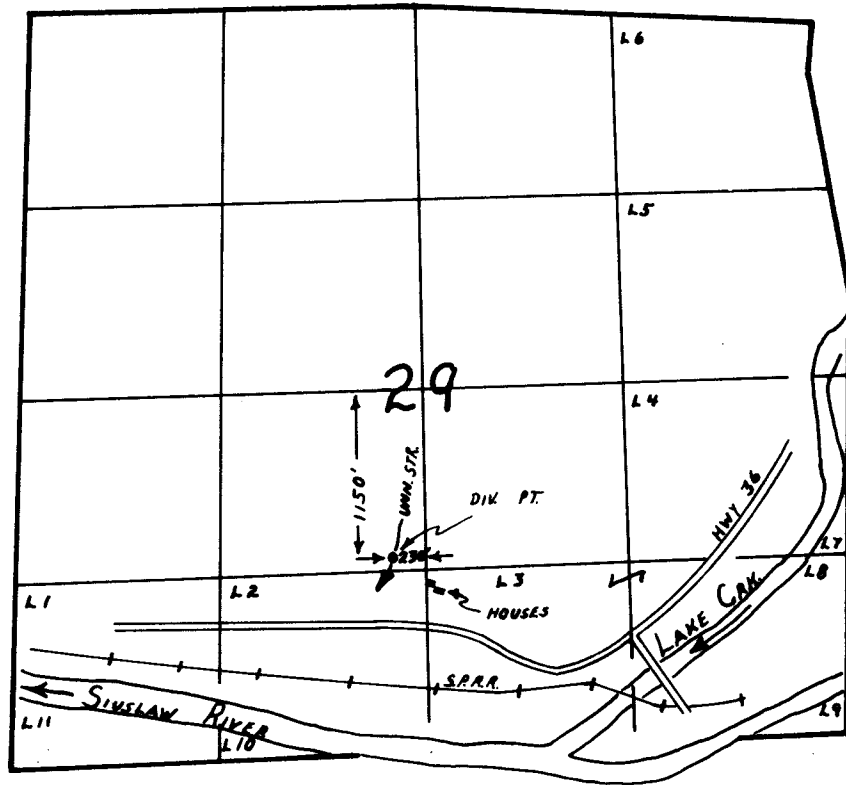

FINAL PROOF SURVEY

UNDER

Application No. 69057 Permit No. 49990
IN NAME OF

VALERIE A. BURNETT

Surveyed NOVEMBER 17, 1992, by R.W. Klassen