


T. 32 & 33 S., R. 6 W., W. M.

SECTIONS 4, 5, 32 & 33

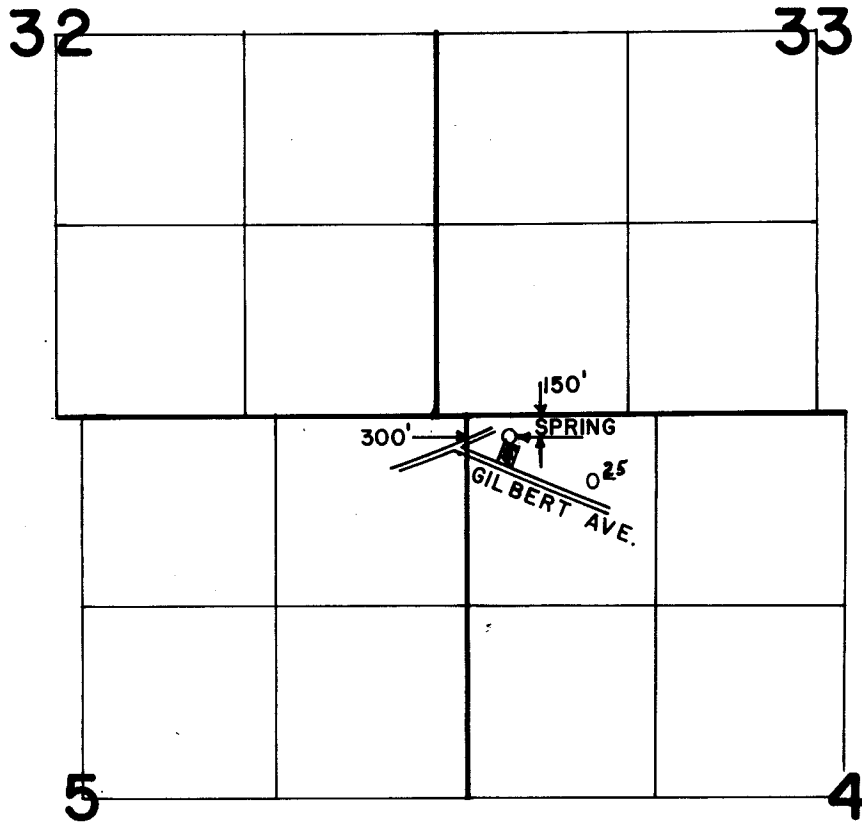

SCALE: 4" = 1 MILE

**FINAL PROOF SURVEY**  
UNDER

Application No. 59328 Permit No. 44643  
IN NAME OF

MARTIN T. BROOKS and or ZELLA R. BROOKS

Surveyed NOV. 29. 1983, by L. E. CASHION...