


T. 2 S., R. 44 E. W. M.

SCALE: 1"=1320'

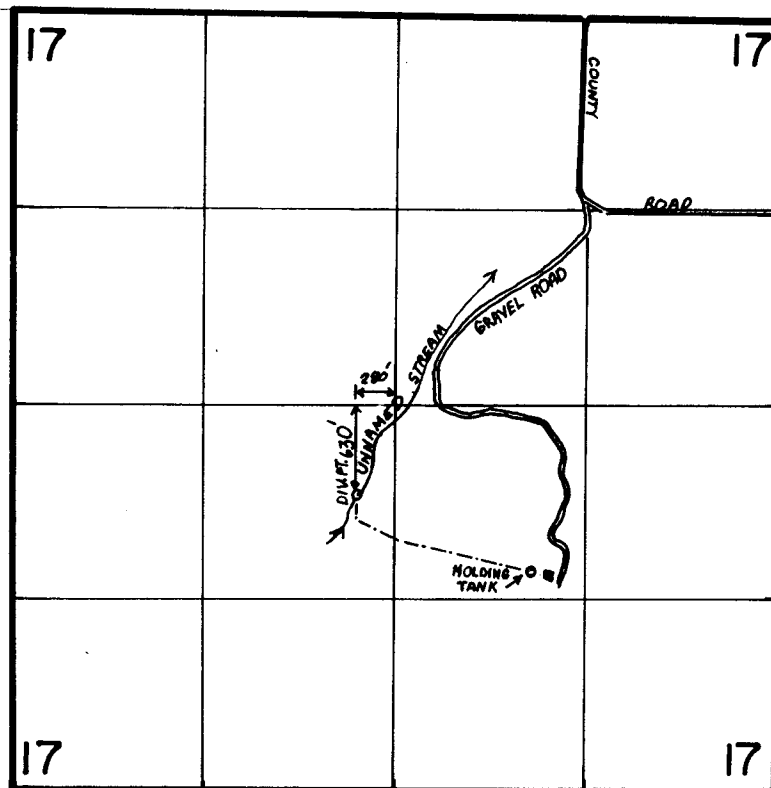

FINAL PROOF SURVEY
UNDER

Application No. 57506... Permit No. 43327...
IN NAME OF

.....Darrold & Kathryn Willis.....

Surveyed SEPT. 28.... 1983., by V.L. CHURCH.....