


THE PREPARATION OF THIS MAP WAS FOR THE PURPOSE OF IDENTIFYING THE LOCATION OF THE WATER RIGHT ONLY AND HAS NO INTENT TO PROVIDE DIMENSIONS OR LOCATION OF PROPERTY OWNERSHIP.

DRAWN BY:
PAUL CHRISTENSEN, PE, CWRE
P.O. BOX 854
SEASIDE, OREGON 97138



CLATSOP COUNTY, OREGON
NE1/4 NE1/4 SEC19
TOWNSHIP 5 NORTH
RANGE 10 WEST
WILLAMETTE MERIDIAN

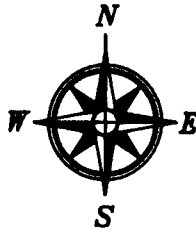

FINAL PROOF SITE MAP
PREPARED BY
JAMES HANNEN
840 N. SPRUCE
P.O. BOX 30
CANNON BEACH, OR 97110
RECEIVED
AUG 24 1994
SALEM, OREGON

FOR TERMS AND CONDITIONS OF:
APPLICATION NO. 71340
PERMIT NO. 51247

DIVERSION POINT LOCATION
35 FEET SOUTH, 300 FEET WEST
OF THE N.E. CORNER OF SECTION 19,
TOWNSHIP 5 NORTH, RANGE 10 WEST,
WILLAMETTE MERIDIAN

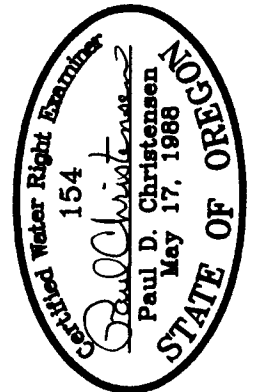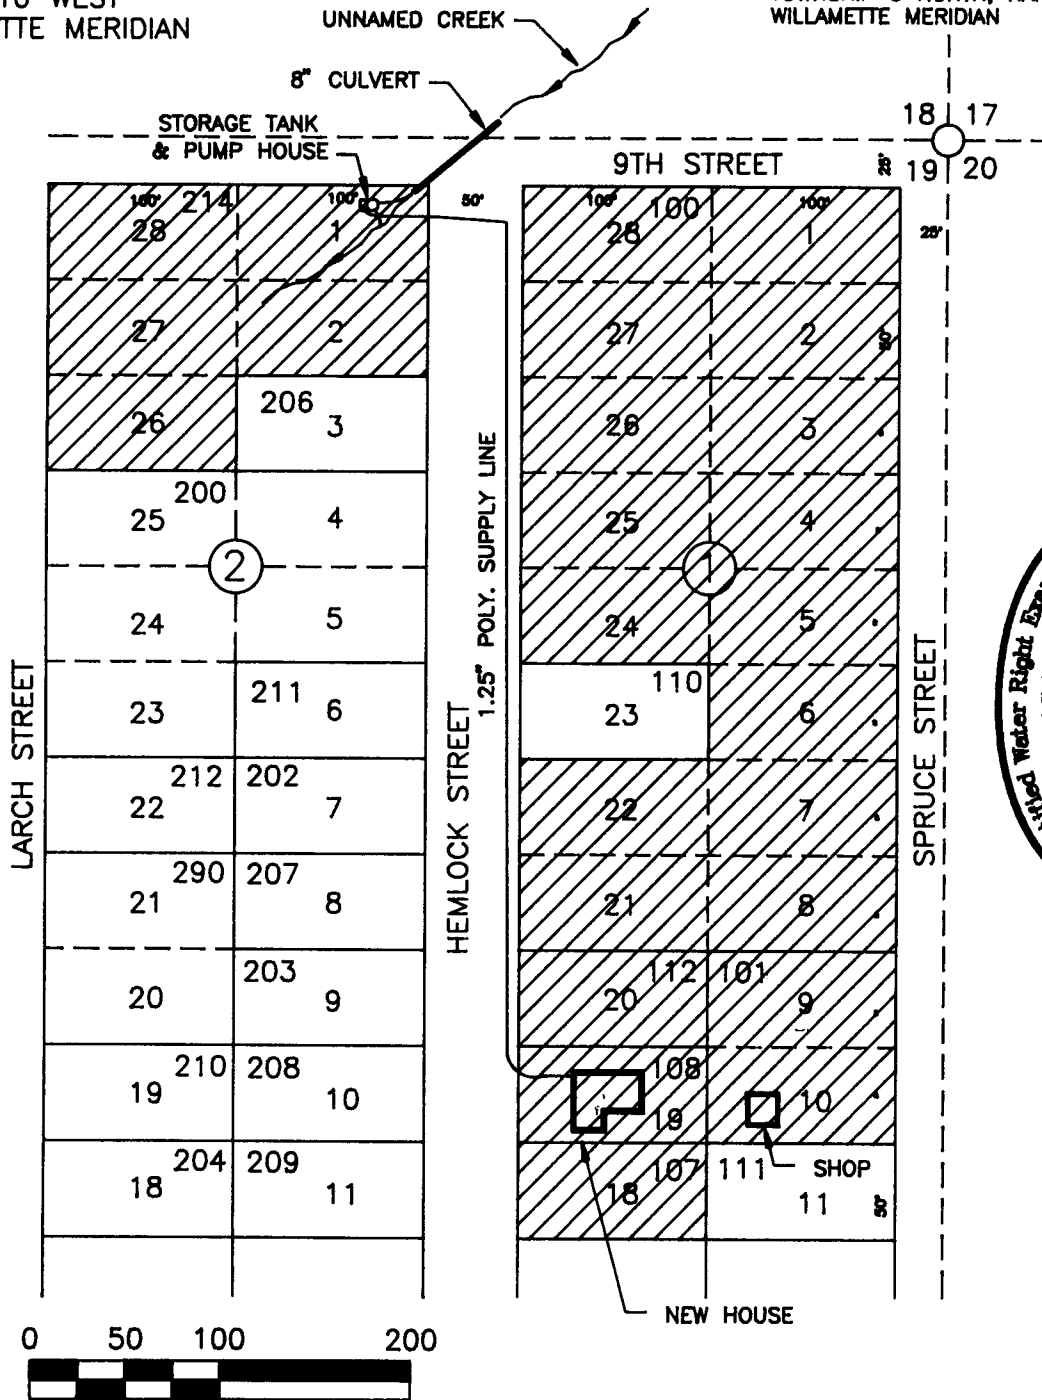

TAX ASSESSOR'S MAP SCALE 1" = 100'