





T.6S. R.6&7W. W.M.

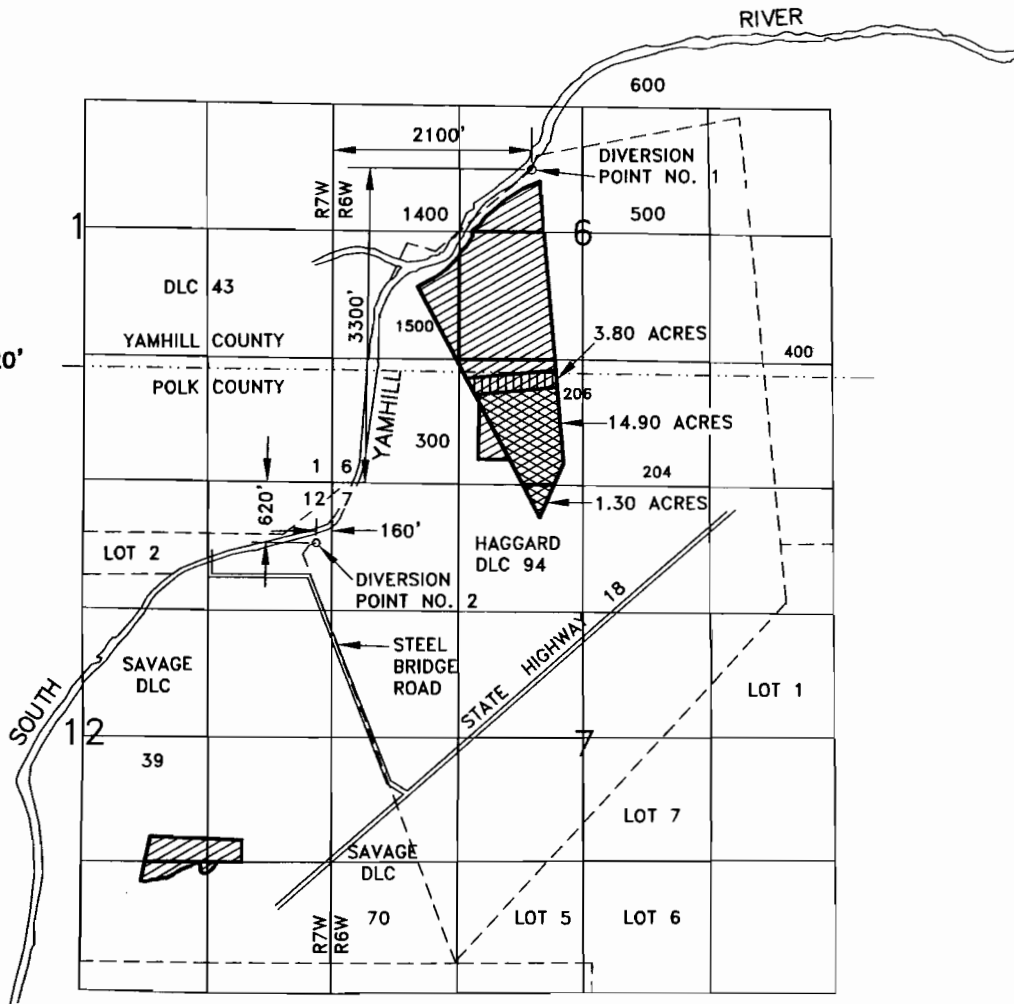

Scale: 1" = 1320'




LEGEND

-  Area of Certificate No. 48075
-  Area to be Transferred to Instream
-  Area of Instream Lease

NOTES:

1. Section lines based on Final Proof Survey for Certificate 45,581.
2. This map was prepared for the purposes of identifying the location of the water right only and is not intended to provide legal dimensions or locations of property ownership lines.

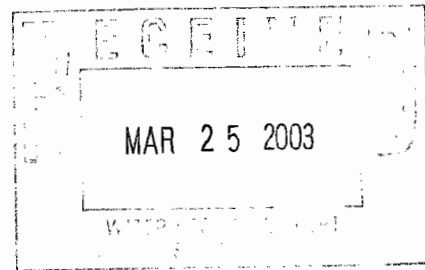

Prepared For:

The Confederated Tribes
9615 Grand Ronde Road
Grand Ronde, Oregon 97347
Phone: (503) 879-2404
Fax: (503) 879-2263

Prepared By:


Leonard A. Rydell, W.R.E.
601 Pinehurst Drive
Newberg, Oregon 97132
Phone: (503) 538-5700
Fax: (503) 538-9167





RENEWAL DATE 12/31/2004

T-9382

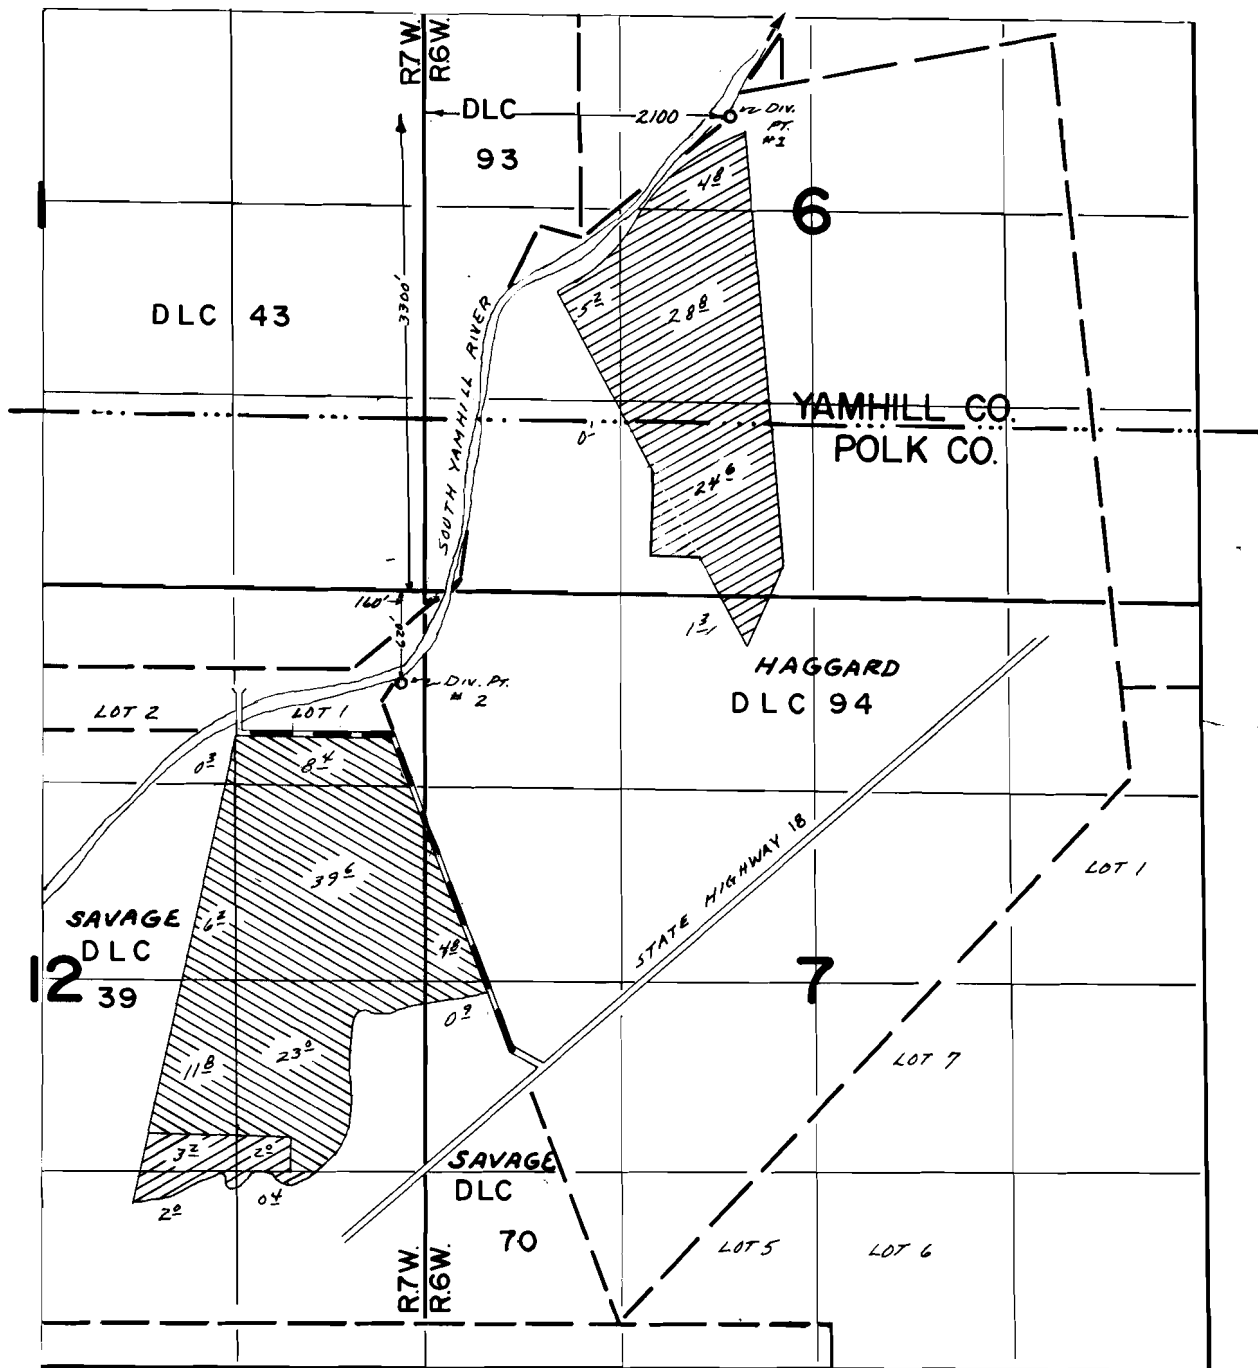T.6S. R.6&7W.W.M.



FINAL PROOF SURVEY UNDER

-  ← A PPL. - 53036
-  ← TRANSFER - 3568

TRANSFER No. 3568
 Application No. 53036. Permit No. 40025.
 IN NAME OF

RICHARD KIRKHAM

Surveyed 3-9 1978, by J.S.DONALDSON