


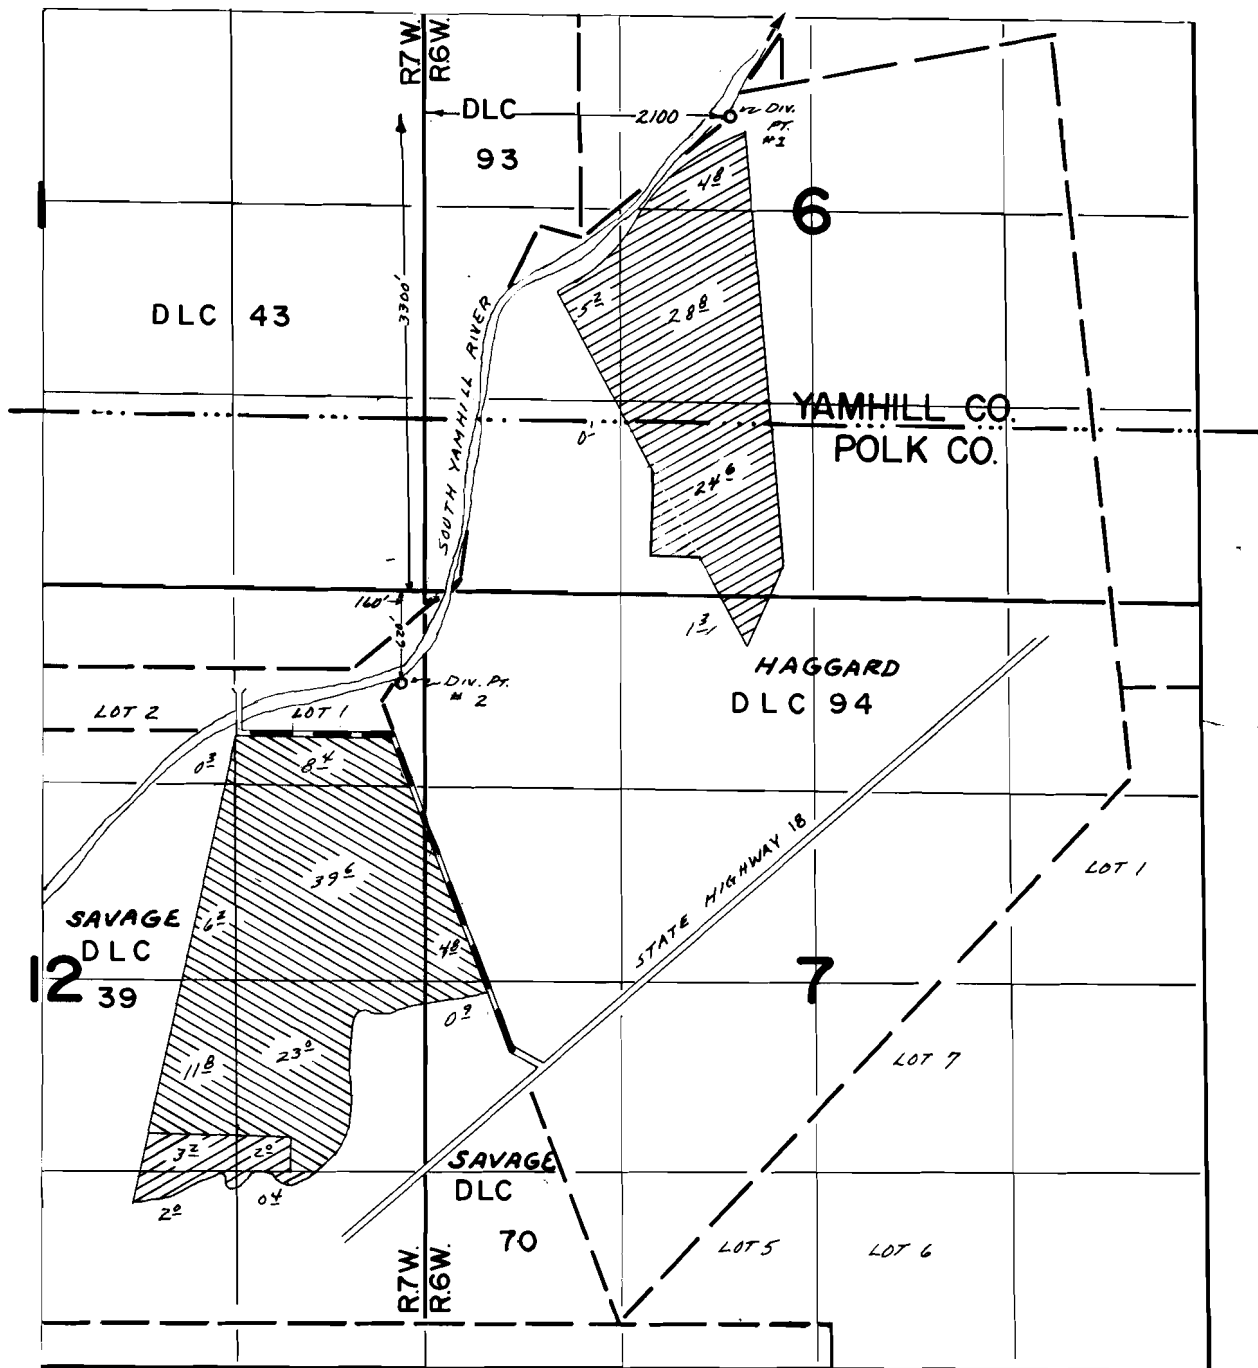

T.6S. R.6&7W.W.M.



FINAL PROOF SURVEY UNDER

-  ← A PPL. - 53036
-  ← TRANSFER - 3568

TRANSFER No. 3568
Application No. 53036. Permit No. 40025.
IN NAME OF

RICHARD KIRKHAM

Surveyed 3-9 1978, by J.S.DONALDSON