

T. 15 S., R. 3 W. U.M.

RECEIVER

SECTION 32

FINAL PROOF SURVEY

RESOURCES DEPT.
SALEM, OREGON

UNDER

TRANSFER FILE T-7127

IN NAME OF

DAVID MALPASS

MUDDY CREEKS IRRIGATION PROJECT

PRIORITY:
DATE

1.) FEBRUARY 9, 1939

2.) MARCH 1, 1978

3.) AUGUST 13, 1986

30 29 29 28

31 32 32 33


POINT OF DIVERSION MUDDY
CREEK. 1350 FEET NORTH &
490 FEET WEST FROM NW COR.
GREENWOOD DLC NO. 64,
SEC. 30, T. 15 S. R. 3 W. U.M.

T. 15 S. 31 32 32 33
T. 16 S. 6 5 5 4

B.P. GREENWOOD DLC 64

32

1.6

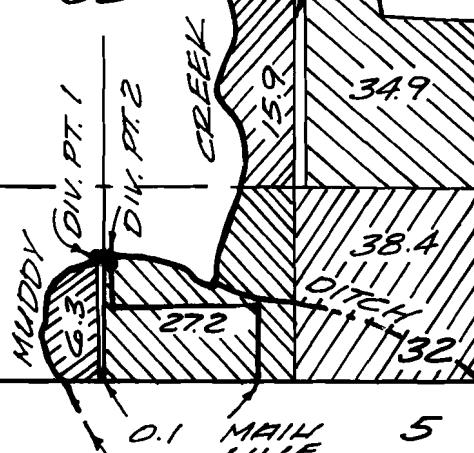

COUNTRY ROAD #523

SCALE
1" = 1320'
JULY 22, 1998


LOCAL:

DIV. PT. 1. 870' N. & 2660' W. FROM
SE COR. SEC. 32.

DIV. PT. 2. 830' N. & 2625' W. FROM
SE COR. SEC. 32.

POINT OF DIVERSION MCKEENIE RIVER
4440' FEET SOUTH AND 5250 FEET
EAST FROM THE SE COR. MALLSFIELD
DLC 79, SEC. 9, T. 17 S. R. 3 W. U.M.

THIS MAP IS FOR WATER RIGHT
PURPOSES ONLY AND IS NOT
INTENDED TO PROVIDE DIMENSIONS
FOR LOCATING PROPERTY BOUNDARIES.
SURVEYED MARCH 2, 1994

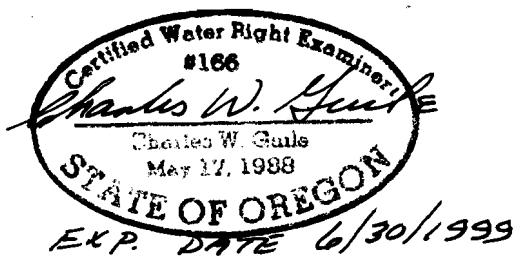

CHARLES W. GUILF
& ASSOCIATES, INC.
LAND SURVEYORS
5700 Southwicks Loop
Eugene, OR 97401

92-41G