T. 15 S., R. 3 W. W. M.
SECTION 32
FINAL PROOF SURVEY
UNDER
TRANSFER FILE T-7127

IN NAME OF
DAVID MALPASS
MUDDY CREEKS IRRIGATION PROJECT

RECEIVED
SEP 1 9 94
WATER RESOURCES
SALEM, OREGON

PRIORITY DATE:
1.) FEBRUARY 9, 1939
2.) MARCH 1, 1978
3.) AUGUST 13, 1986

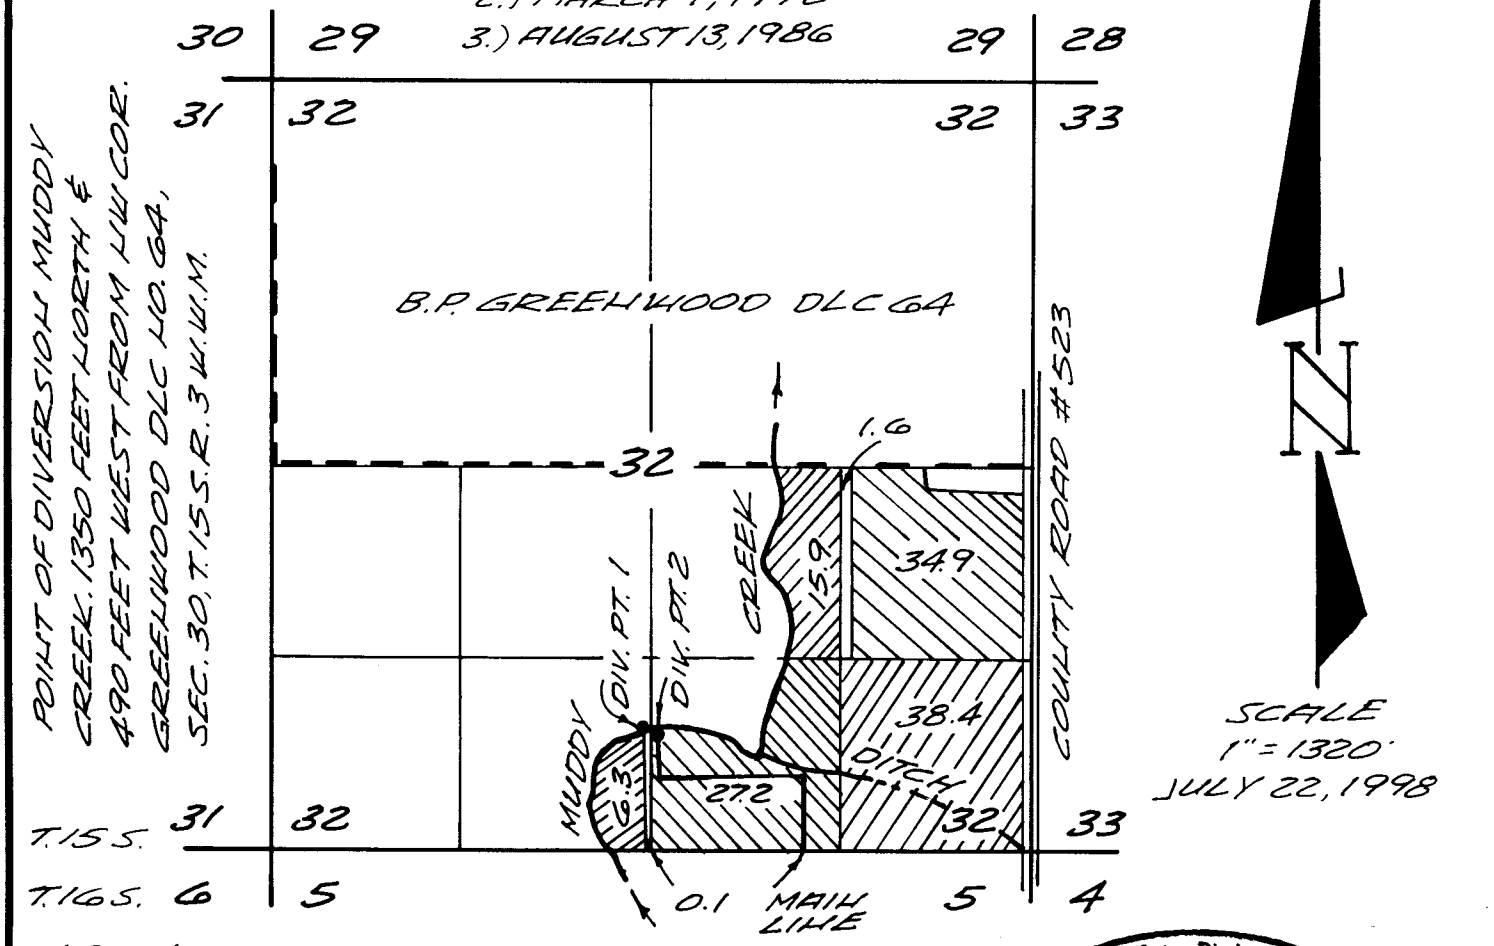

LOCAL:
DIV. PT. 1. 870' N. & 2660' W. FROM SE COR. SEC. 32.
DIV. PT. 2. 830' N. & 2625' W. FROM SE COR. SEC. 32.
POINT OF DIVERSION McKENZIE RIVER 4440' FEET SOUTH AND 5250 FEET EAST FROM THE SE COR. MANSFIELD DLC 79, SEC. 9, T 17 S. R. 3 W. W. M.

THIS MAP IS FOR WATER RIGHT PURPOSES ONLY AND IS NOT INTENDED TO PROVIDE DIMENSIONS FOR LOCATING PROPERTY BOUNDARIES.
SURVEYED MARCH 2, 1994

Certified Water Right Examiner
#166
Charles W. Guile
Charles W. Guile
May 17, 1988
STATE OF OREGON
EXP. DATE 6/30/1999

CHARLES W. GUILE
& ASSOCIATES, CO.
Land Surveyors
52 Centennial Loop
Eugene, OR 97401

92-41G