T. 16 S. R. 4 W. W.M.

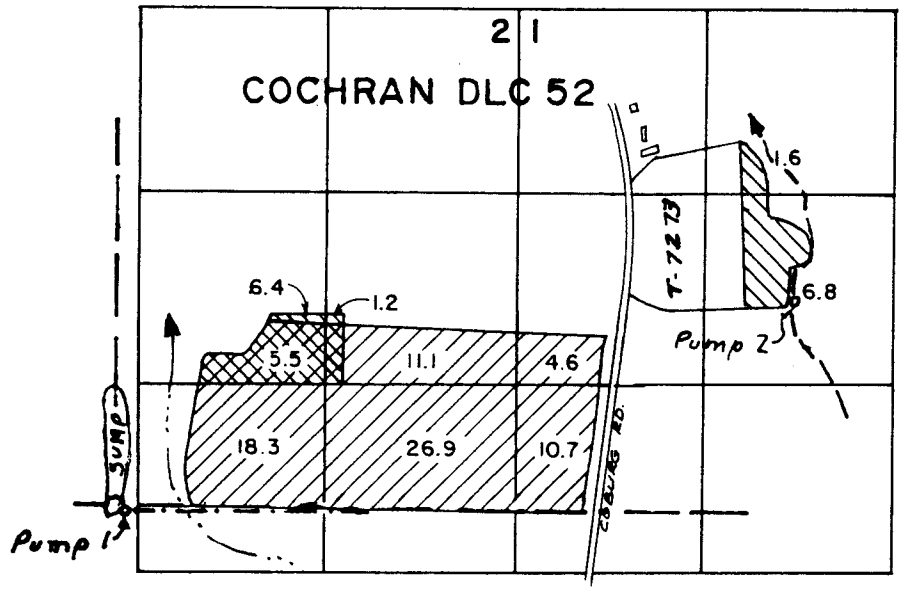

4" = 1 MI.

FROM

TO

T. 16 S. R. 3 W. W.M.

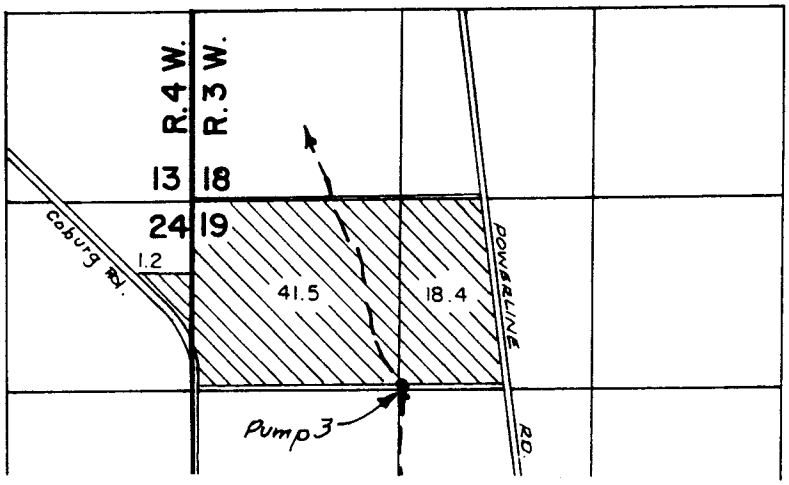

FINAL PROOF SURVEY

UNDER

TRANSFER NO. T-7230

~~Application No. ..... Permit No. .....~~

IN NAME OF

HAYWORTH FARMS, INC.

THIS MAP WAS PREPARED FOR THE PURPOSE OF IDENTIFYING THE LOCATION OF A WATER RIGHT ONLY AND IS NOT INTENDED TO PROVIDE LEGAL DIMENSIONS OR LOCATION OF PROPERTY OWNERSHIP LINES.

Surveyed Aug. 15, 2000 by .....

Certified Water Right Examiner
229WRE
Larry W. Jebousek
Larry W. Jebousek
Dec 7. 1989
STATE OF OREGON

WAC-940R 7-16 & 6-225