


T.2N. R.32E. W.M.

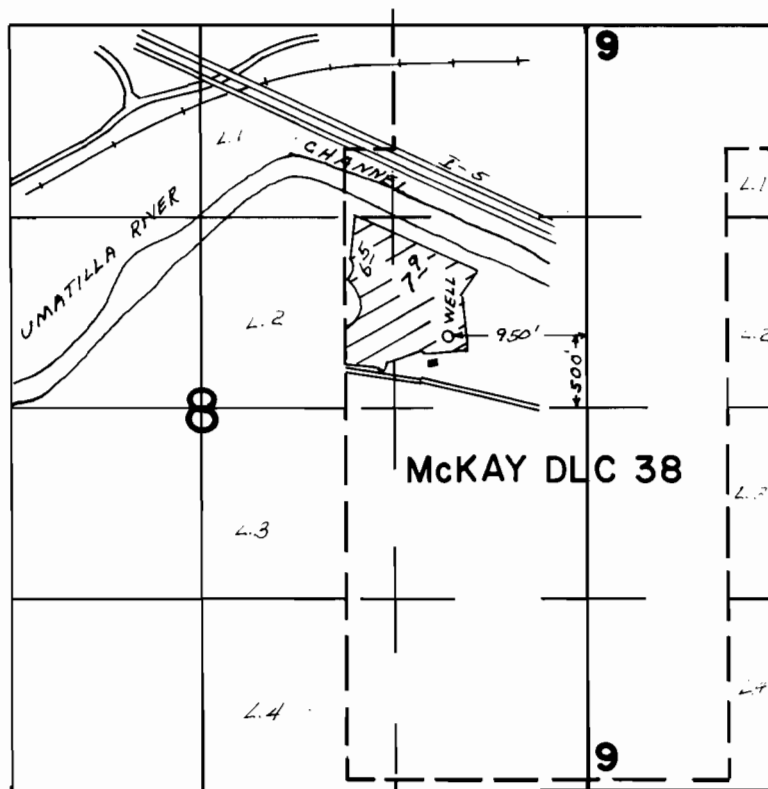

**FINAL PROOF SURVEY**  
UNDER

Application No. G-6605... Permit No. G-6188...  
IN NAME OF

JAMES L. & LAUREL COX

Surveyed MAY 4 1977, by L.H. NUNN