


T. 4 N., R. 25 E., W.M.

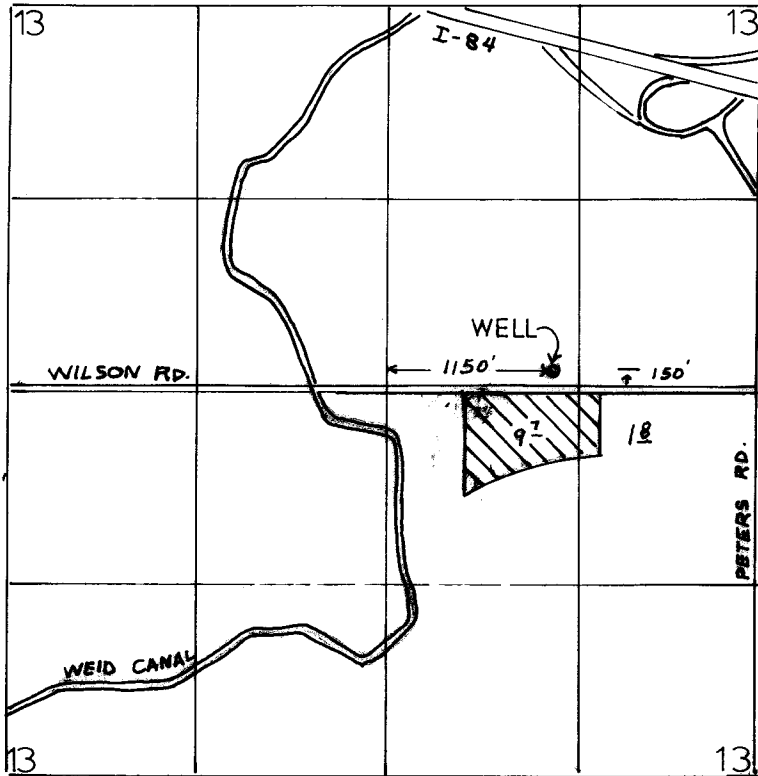

1" = 1320'

FINAL PROOF SURVEY
UNDER

Application No. G-10644 Permit No. G-9811
IN NAME OF

HILLVIEW DAIRY, INC.

Surveyed May 19, 1994, by J. Miller

Revised 4-30-03 JCB
41049-1308-36L, 11-14-97. JMW.