


T. 4 S. R. 13 E. W.M.

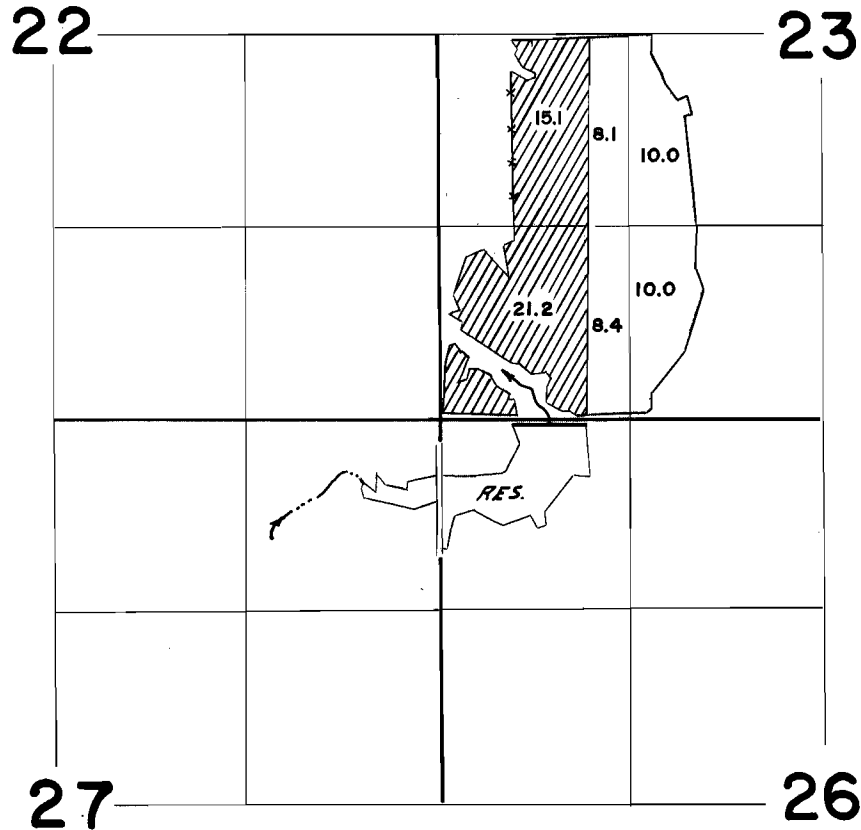

FINAL PROOF SURVEY
UNDER

38430


28619

Application No. R-38429 Permit No. R-3212
IN NAME OF

GLENN E. CHASTAIN

Surveyed JUNE 9 1965, by C. GARDNER
MAY 20 L. COLEBANK

T. 4 S. R. 13 E. W.M.

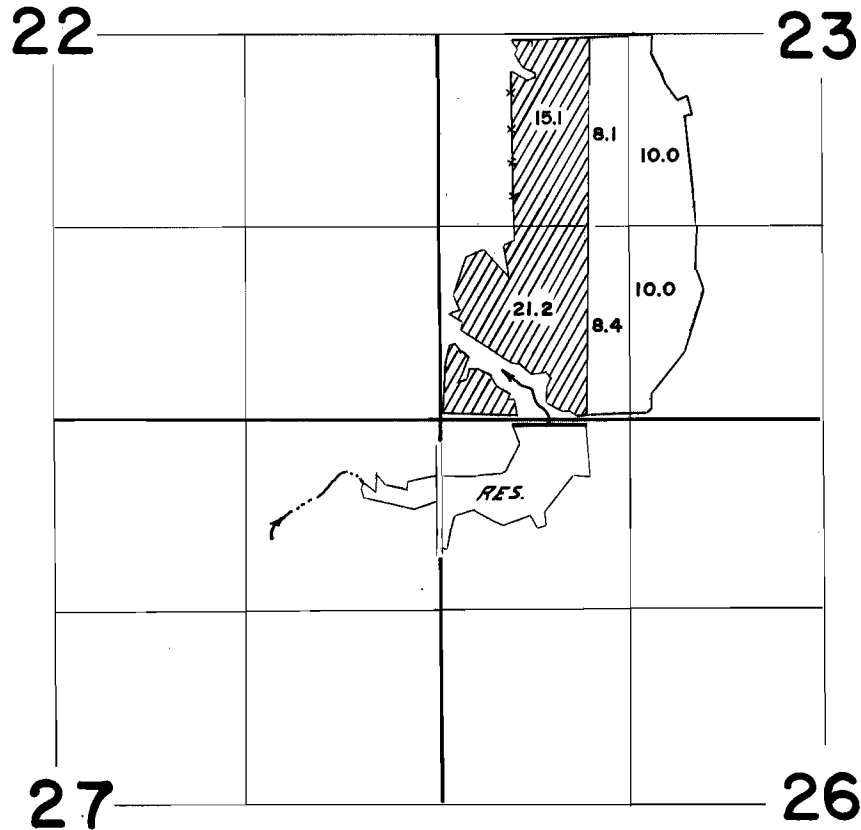

FINAL PROOF SURVEY
UNDER

38430

28619

Application No. R-38429 Permit No. R-3212
IN NAME OF

GLENN E. CHASTAIN

Surveyed JUNE 9 1965, by C. GARDNER
MAY 20 L. COLEBANK