




FINAL PROOF MAP - PERMIT G-12718
APPLICATION G-14028

LOCATED IN THE NE 1/4 OF THE NE 1/4 OF
SECTION 33, T. 14 S., R. 12 E., W.M.
DESCHUTES COUNTY, OREGON

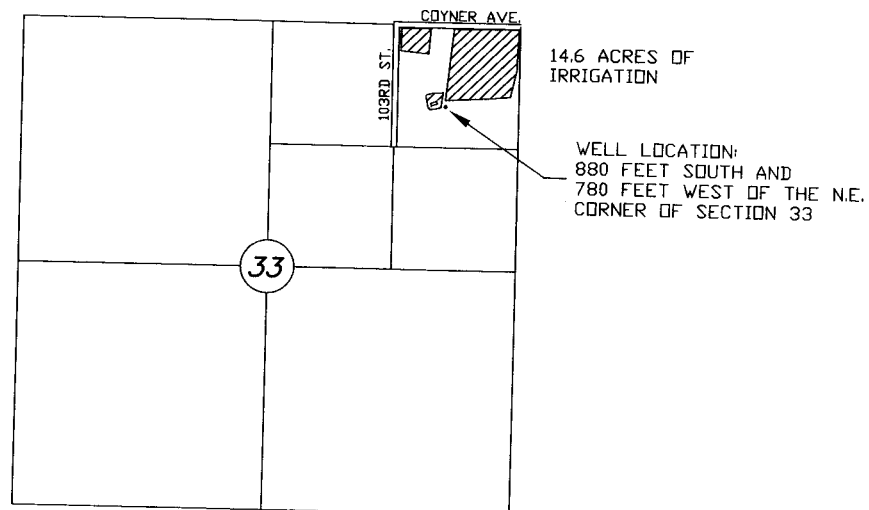

14.6 ACRES OF
IRRIGATION

WELL LOCATION:
880 FEET SOUTH AND
780 FEET WEST OF THE N.E.
CORNER OF SECTION 33



= IRRIGATED AREA
14.6 ACRES


RECEIVED

SEP 05 2000

WATER RESOURCES DEPT.
SALEM, OREGON

I, ROBERT E. BAXTER, CERTIFIED WATER RIGHT EXAMINER
IN THE STATE OF OREGON, HEREBY CERTIFY THAT THIS
WATER RIGHT SURVEY MAP WAS PREPARED BY ME.

THE PREPARATION OF THIS MAP IS FOR THE PURPOSE
OF IDENTIFYING THE LOCATION OF THE WATER RIGHT
ONLY AND HAS NO INTENT TO PROVIDE DIMENSIONS OR
LOCATIONS OF PROPERTY OWNERSHIP LINES.

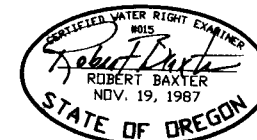

PREPARED BY
BAXTER LAND SURVEYING, INC.
20370 EMPIRE AVE. SUITE C3
BEND, ORE. 97701 (541) 382-1962

FINAL PROOF MAP
FOR
LARRY AND NANCY BROWN

PREPARED FOR: LARRY AND NANCY BROWN
PO BOX 987
REDMOND, OREGON 97756 (541)-923-0642
SCALE: 1" = 1320'
DATE: 8-28-00