


T. 1 S. R. 38 E. W. M.

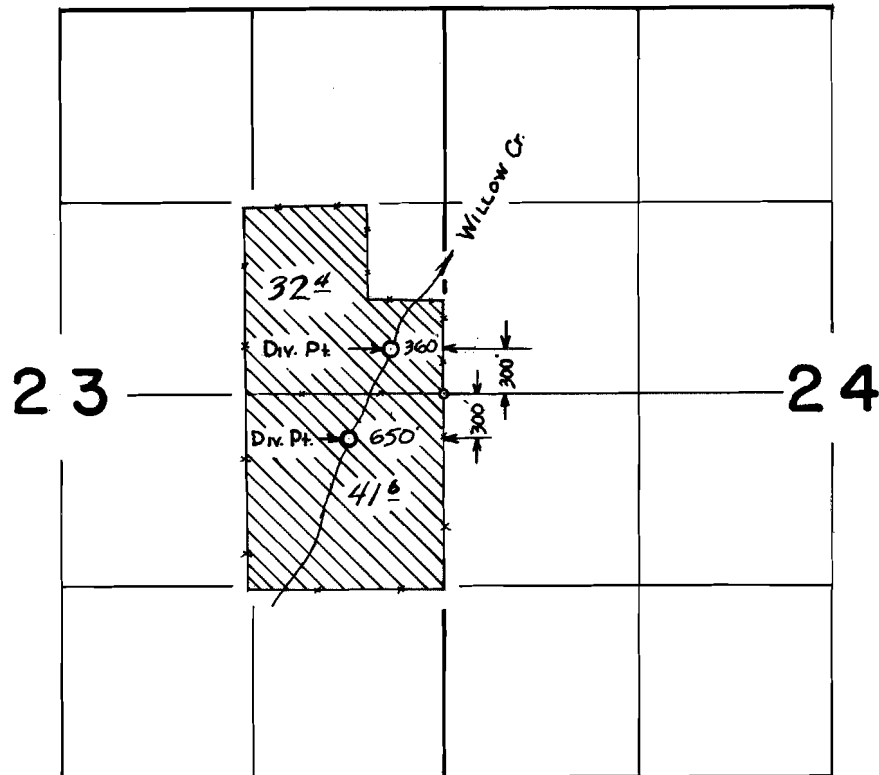

FINAL PROOF SURVEY
UNDER

Application No. 40742... Permit No. 30343...
IN NAME OF

BESSIE E. HALE

Surveyed 23 JULY 1969, by W. J. RUPPERT