

RR 80397


WESTLAND IRRIGATION DISTRICT Final Proof Map for Transfer T-8320

4N 28E W.M.

RECEIVED


APR 17 2006


WATER RESOURCES DEPT
SALEM, OREGON

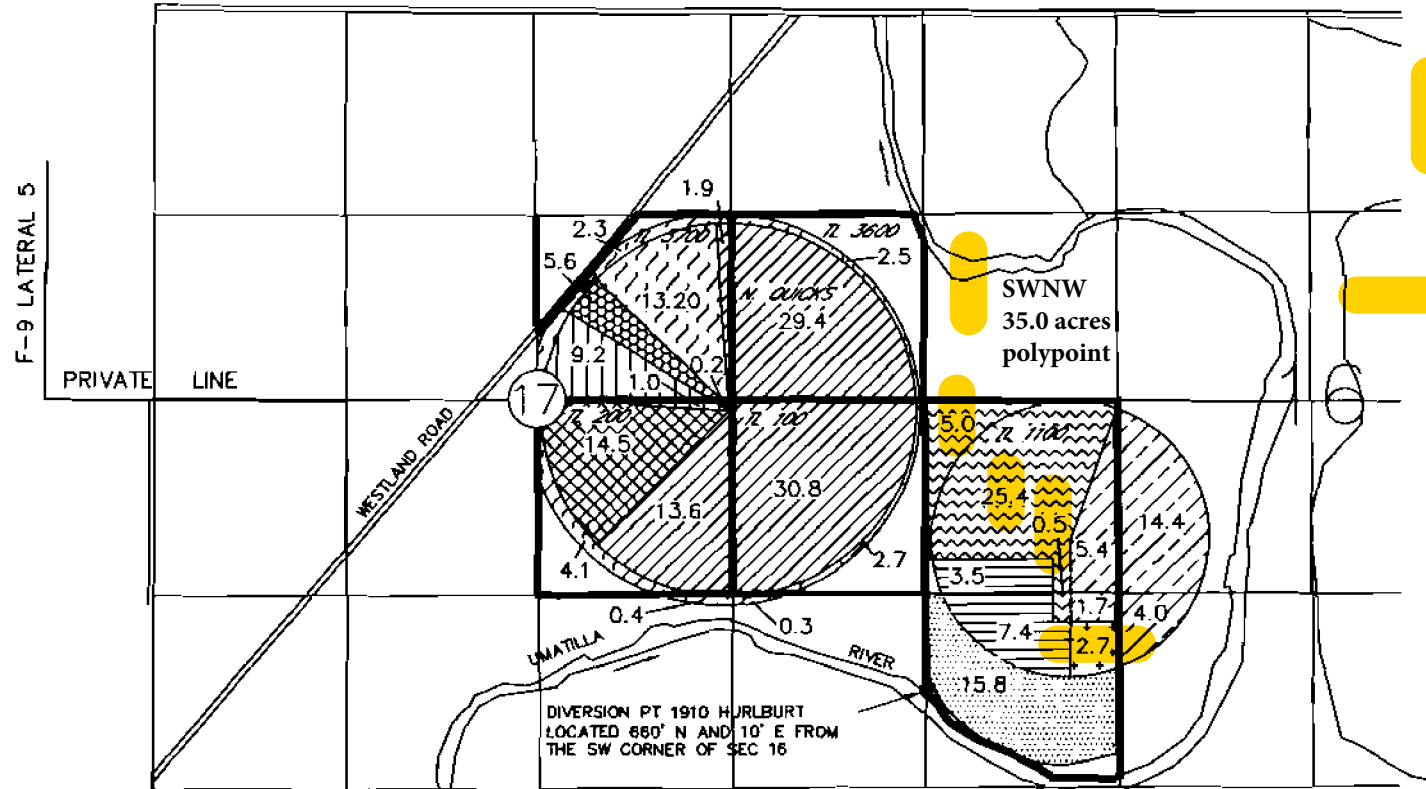



RR 80397 65.9 ac Primary IR


RR 80397 2.7 ac Supplemental IR

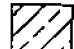
 Primary 76718 - 1907 Westland
 Supplemental 79439 (1924 McKay)
 80395 (55323) 1979 Quick diminished to supplemental


 Primary 76718 - 1907 Westland
 Supplemental 79439 - 1924 McKay
 2554 - 1910 Hurlburt diminished to supplemental


 Diminish 80397 (2554) to
 supplemental to 80396 (76718)


 Diminish 80395 (55323) to
 supplemental to 76799


 55323 - 1979 Quick from T-8322
 not involved with this transfer

 2554 - 1910 Hurlburt from T-8322
 not involved with this transfer

 Primary 80397 (2554) - 1910 Hurlburt
 not involved with this transfer

 Primary 76799 - 1961 Westland w/McKay
 Supplemental 80395 (55323) - 1979 Quick
 not involved with this transfer

 Primary 80395 (55323) - 1979 Quick
 not involved with this transfer

 Primary 76717 (1907 Westland)
 Supplemental 79439 - 1924 McKay
 Supplemental 80395 (55323) - 1979 Quick
 not involved with this transfer

NOTE:
 The purpose of this map is to identify the approximate location
 of the water right. It is not intended to provide information
 relative to the location of property ownership boundary lines.