

T.1S., R.5E., W.M.
SECTIONS 1 & 12


RECEIVED

APR 08 2002

WATER RESOURCES DEPT.
SALEM, OREGON

2

SECTION CORNER
BRASS CAP FOUND
N 45°30.2705'
W 122°8.8119'

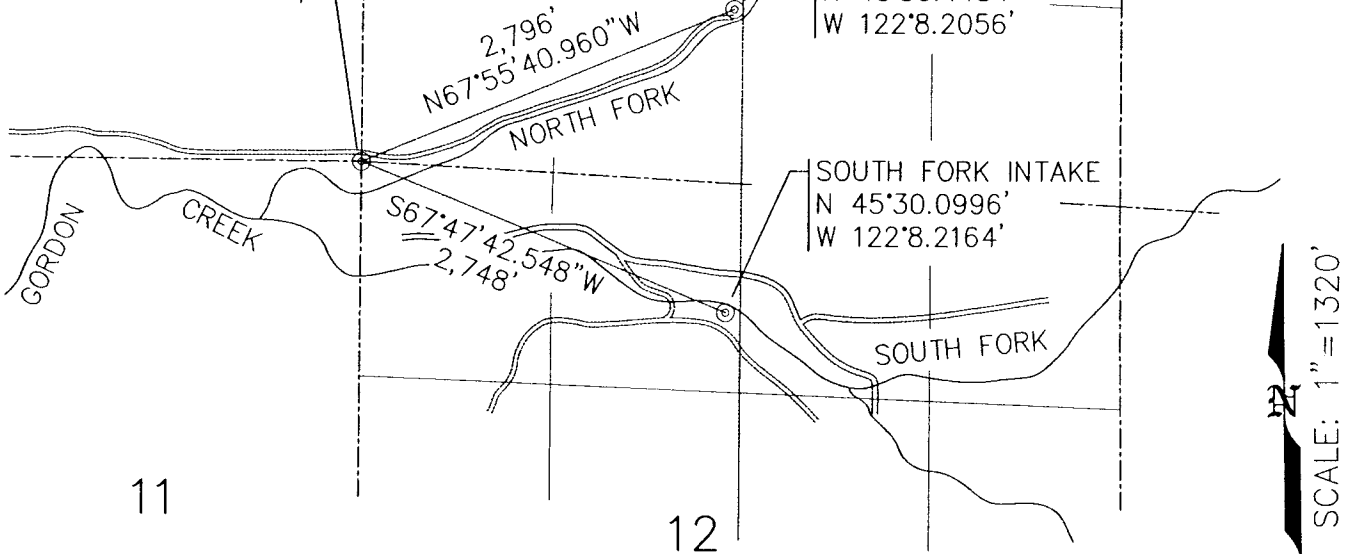


SCALE: 1" = 1320'

THIS MAP IS FOR THE PURPOSE OF
IDENTIFYING THE LOCATION OF POINT(S)
OF DIVERSION AND PLACE(S) OF USE OF
THE WATER RIGHTS ONLY AND IS NOT
INTENDED TO PROVIDE LEGAL DIMENSIONS
OF THE PROPERTIES ILLUSTRATED HEREIN.

GPS DATUM NAD83

FINAL PROOF SURVEY
UNDER

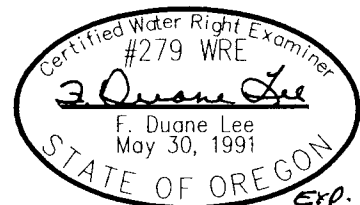

APPLICATION NO. S-15024 AND S-16229 PERMIT NO. S-11882 AND S-12154

IN NAME OF:

CORBETT WATER DISTRICT

Surveyed: FEB 1999 AND MARCH 2002, by F. Duane Lee, WRE, PE

OWNER:

CORBETT WATER DISTRICT

LEE ENGINEERING, INC.
1300 JOHN ADAMS ST.
OREGON CITY, OR, 97045

DWG TITLE:

FINAL PROOF SURVEY

DATE:
SEPT 2000
FILE NO:
2443PS01

REVISED:

1 / 1