T. 3 S., R. 1 W., W.M.

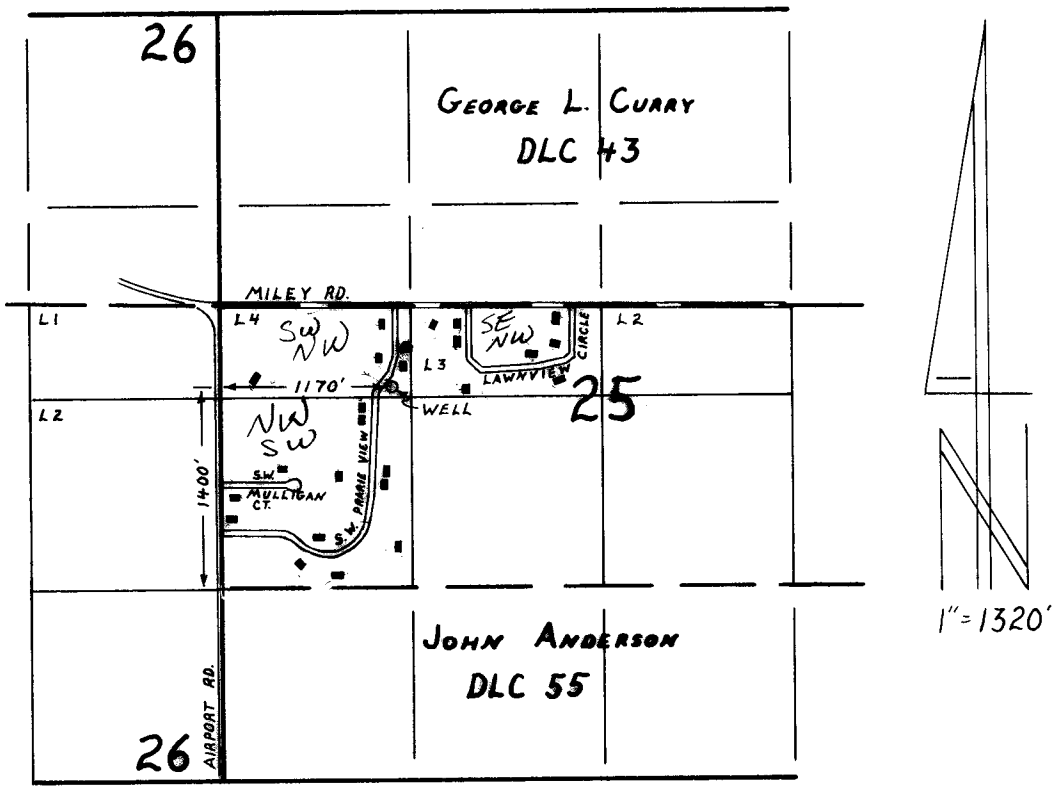

FINAL PROOF SURVEY

UNDER

Application No. G-6365 Permit No. G-5961

IN NAME OF

[redacted]

Timothy Grossnickle

Surveyed OCTOBER 20, 1992, by R.W. Klassen

WAC 900R 9-14 RWK 2/93