


T. 33 S., R. 11 W., W.M.

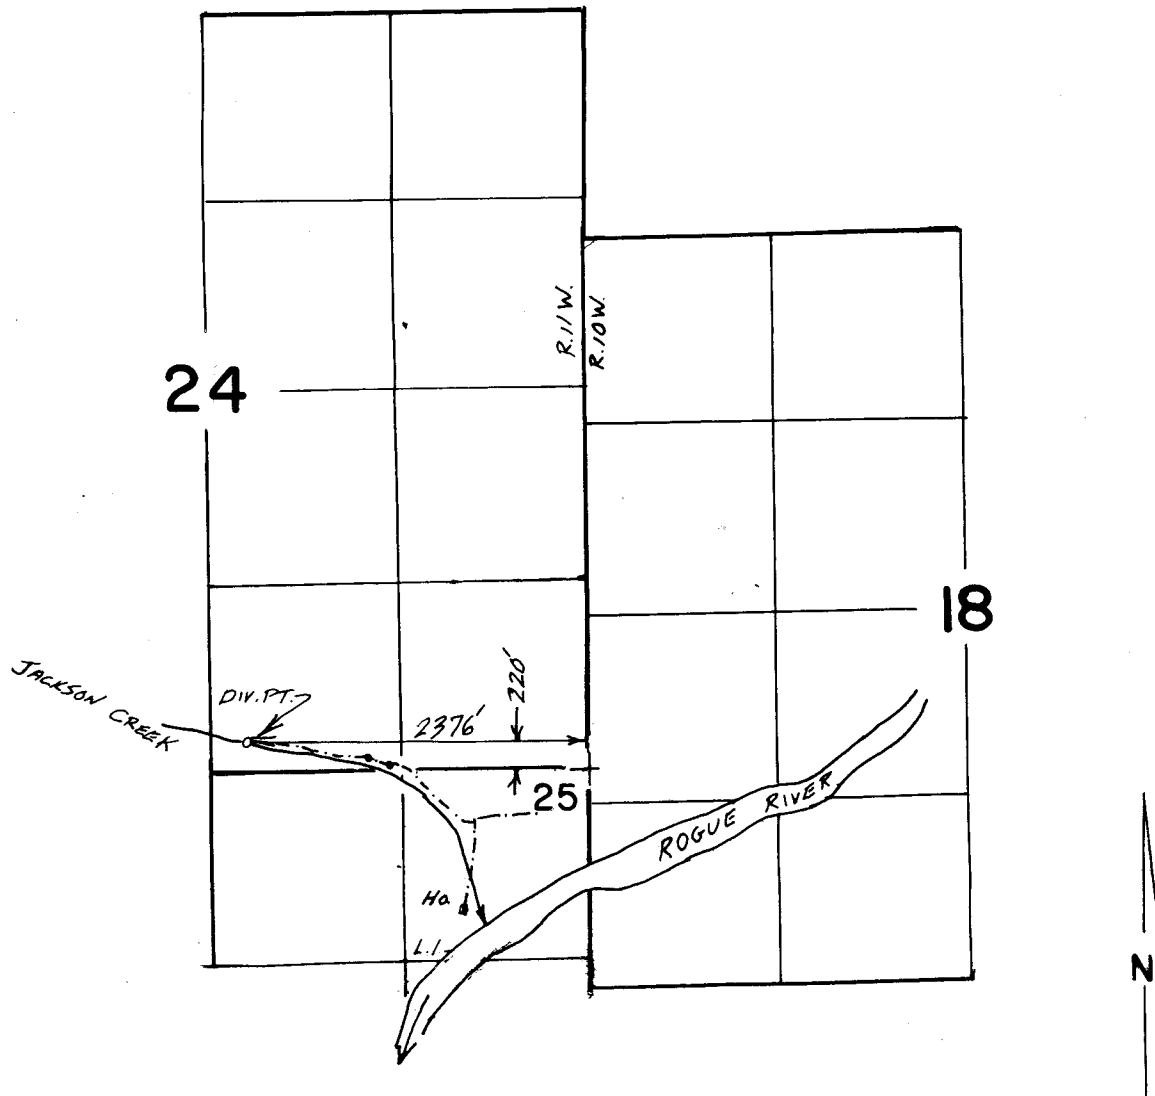

Scale 1" = 1320'

**FINAL PROOF SURVEY**  
UNDER

Application No. 49960 Permit No. 36763...  
IN NAME OF

WILLIAM LEEVER, RALPH HIBBS, JAMES PARSONS

Surveyed JULY 31 1999, by B.S. DeHaas...

616108-288-305-000000

2/20/00