# T. 6 N., R. 5 W., W.M.

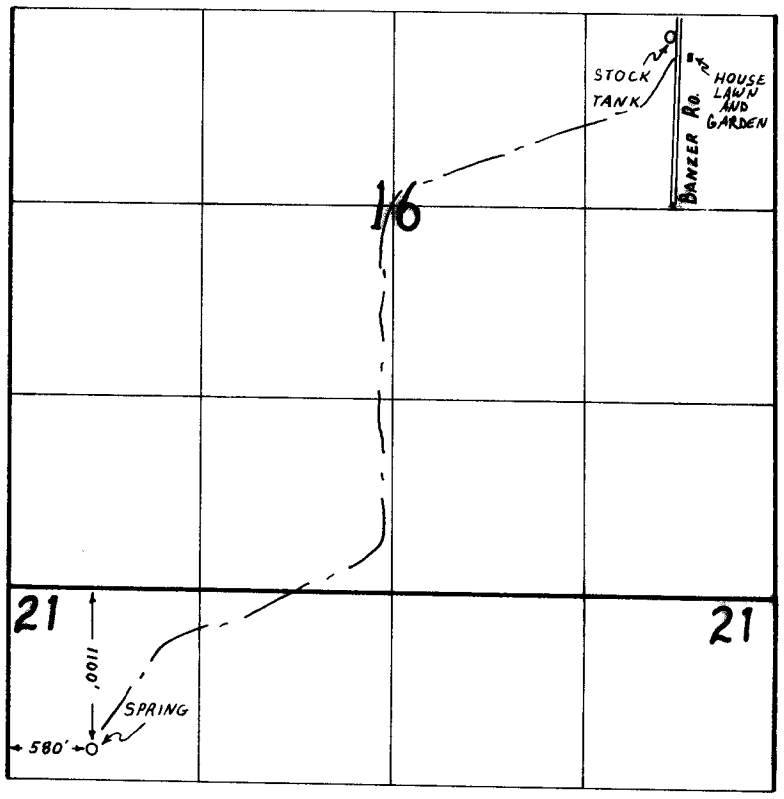


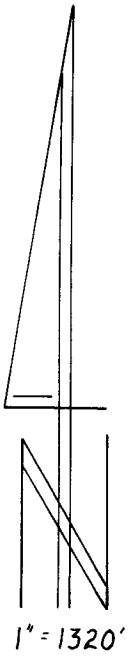


# FINAL PROOF SURVEY

UNDER

Application No. 54863 Permit No. 41153

IN NAME OF

JOSEPH D. BANZER

Surveyed JULY 16, 1992, by R.W. Klassen

WAC 900R 8-217 RWK 2/93
Revised GC 4/30/03