


T. 8 S., R. 36 E., W.M.

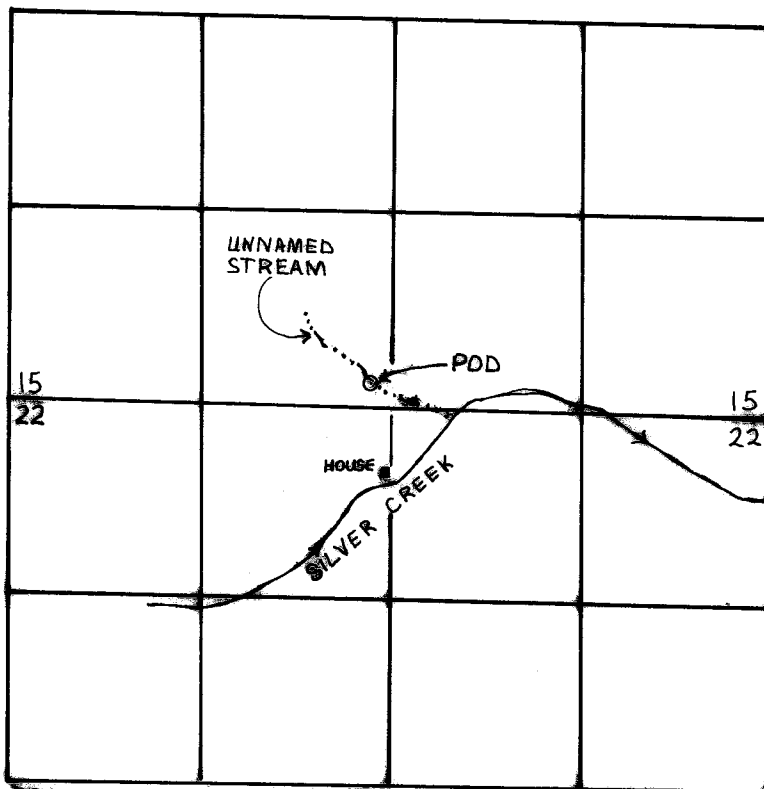

POD - 160' N. & 140' W. FROM S 1/4 C. SECTION 15.

1" = 1320'

FINAL PROOF SURVEY

UNDER

Application No. 64165 Permit No. 47161
IN NAME OF

BETTY L. TERRY

Surveyed 8-17, 1990, by K. KEMP

(from Quid)