


T.41S.R.13W.W.M.

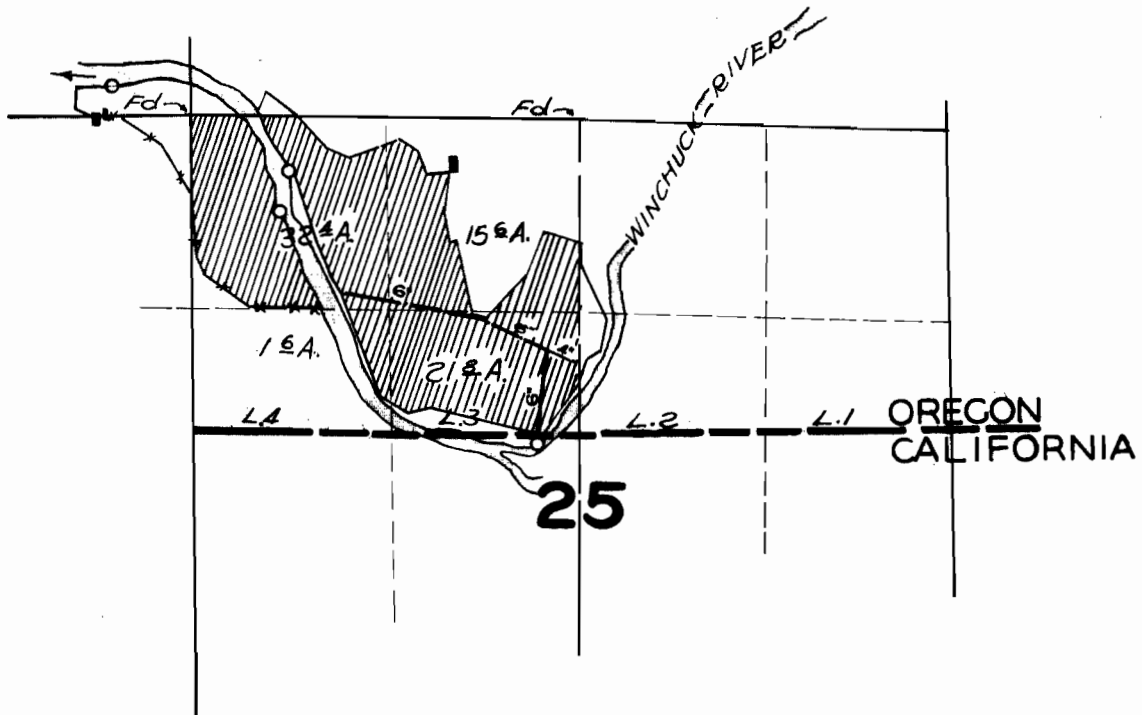

○ = DIVISION POINT
■ = BUILDINGS

FINAL PROOF SURVEY UNDER

Application No. 21640... Permit No. 17001...
IN NAME OF

M.L. DEMARTIN

Surveyed AUG. 9, 1949., by H.L. COFFMAN.