


T.2S.,R.2E.,W.M.

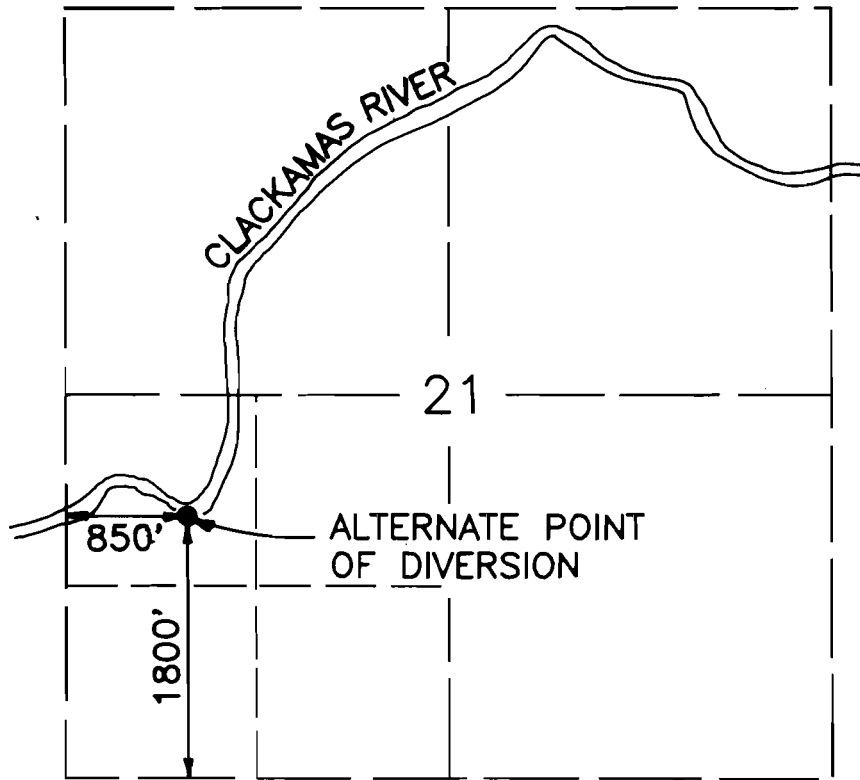

SCALE: 1"=1320'



TRANSFER OF CERTIFICATE No. 1067
(TRANSFER APPLICATION No. T-6162)

ALTERNATE POINT OF DIVERSION

SOUTH FORK WATER BOARD
JULY, 1990

