


# T.8N.R.7 W.W.M.

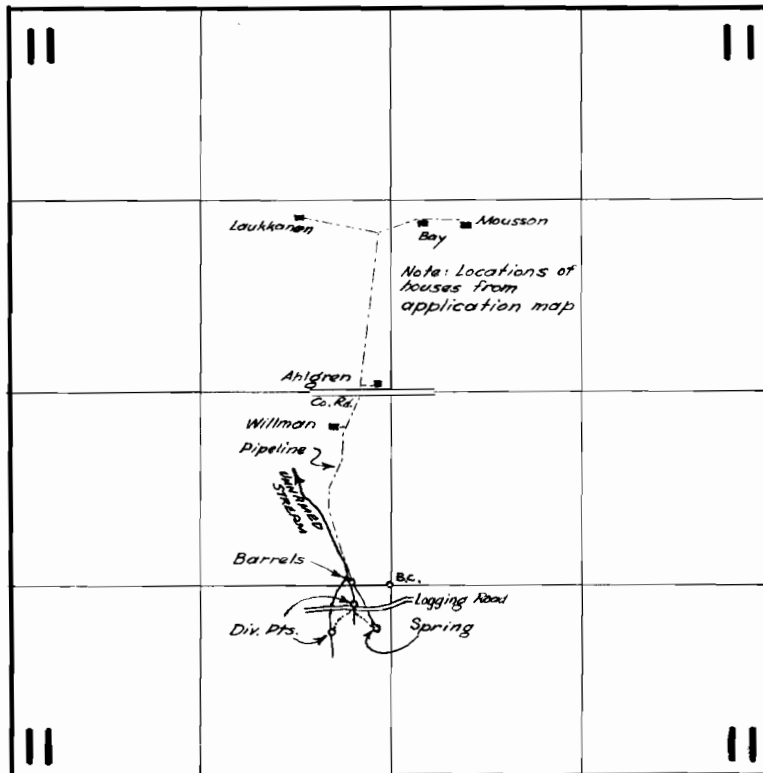

## FINAL PROOF SURVEY UNDER

Application No. **34609** Permit No. **27175**  
IN NAME OF

**H. E. WILLMAN**

Surveyed July 9, 1962, by R.H. Jackson  
May 20, 1964, by M. Bish