


T.25S.,R.14E.,W.M.

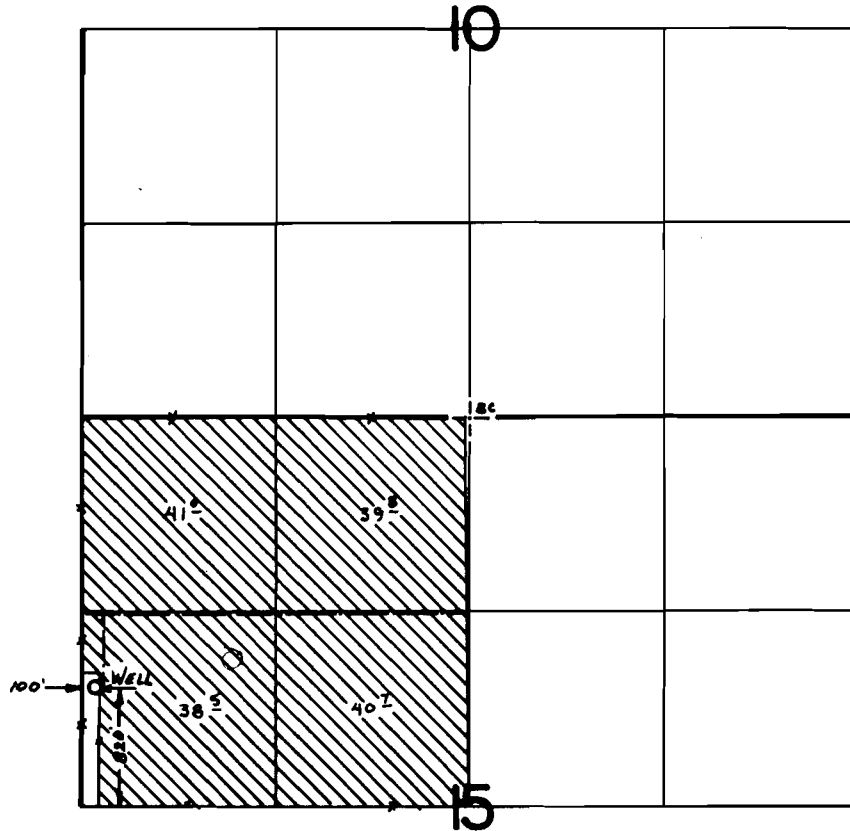

FINAL PROOF SURVEY UNDER

Gordon (Hamlington)

Application No. G-9547. Permit No. G-8841.....
IN NAME OF

.....**LEROY SURCAMP**.....

Surveyed Aug. 27. 1983., by L. M. TOLL.....