


CLAIM OF BENEFICIAL USE MAP
SW 1/4 Section 21, T.28S. R.14E., W.M.
TAX LOT 2400
Lake County, Oregon

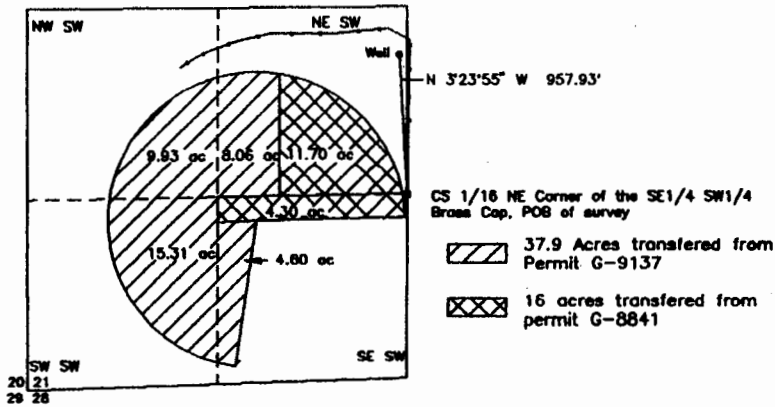

SCALE
1" = 1320'

LANCE & CARRIE BROWN
TAX LOT 2400




RECEIVED

MAR 25 2003

WATER RESOURCES DEPT.
SALEM, OREGON

Survey by: Sundel & Associates
P.O. Box 1228
Lakeview, OR 97630
541-947-3293
November 2002 Dr #16603/p

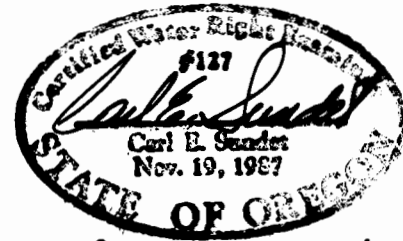

Renews 6/30/09

This map is for the purpose of locating the water right only and is not intended to show legal dimensions or property ownership lines.