




T.35&36S.R.12E.W.M.

34

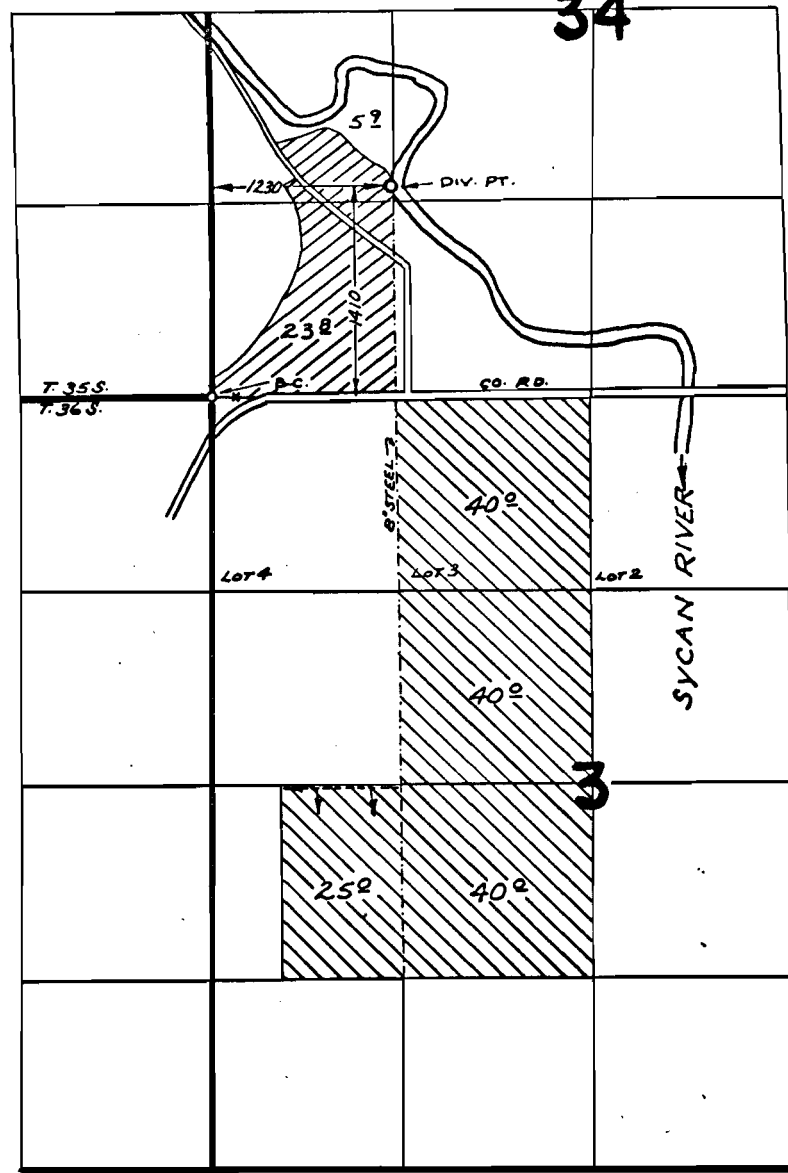

Sycan R. b/w. Sycan Marsh

PRIMARY  SUPPLEMENTAL 

FINAL PROOF SURVEY UNDER

Application No. *41439*.... Permit No. *31116*.....
IN NAME OF

GLEN and ALDA ISRAEL and PHILIP ISRAEL

Surveyed *DEC. 23, 1974.*, by *R. MUCKEN.*