


T.15S. R.10E. W.M.

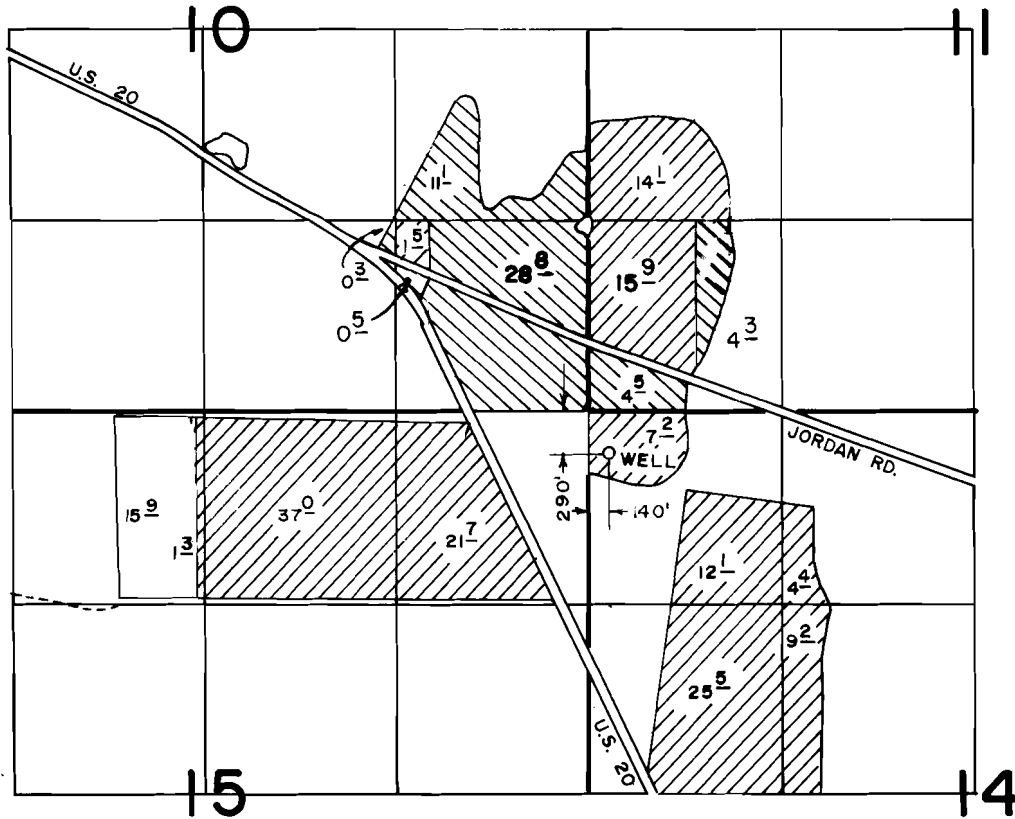

FINAL PROOF SURVEY
UNDER

Application No. G-5295, Permit No. G-4841.....
IN NAME OF

L.F. BROGAN

Surveyed APR. 24, 1980., by L.H. NUNN.....