


MAP

TO ACCOMPANY APPLICATION
OF WM. HASSE
FOR PERMIT
TO APPROPRIATE WATER



SECTION 25, T.4 S., R.38 E. W.M.

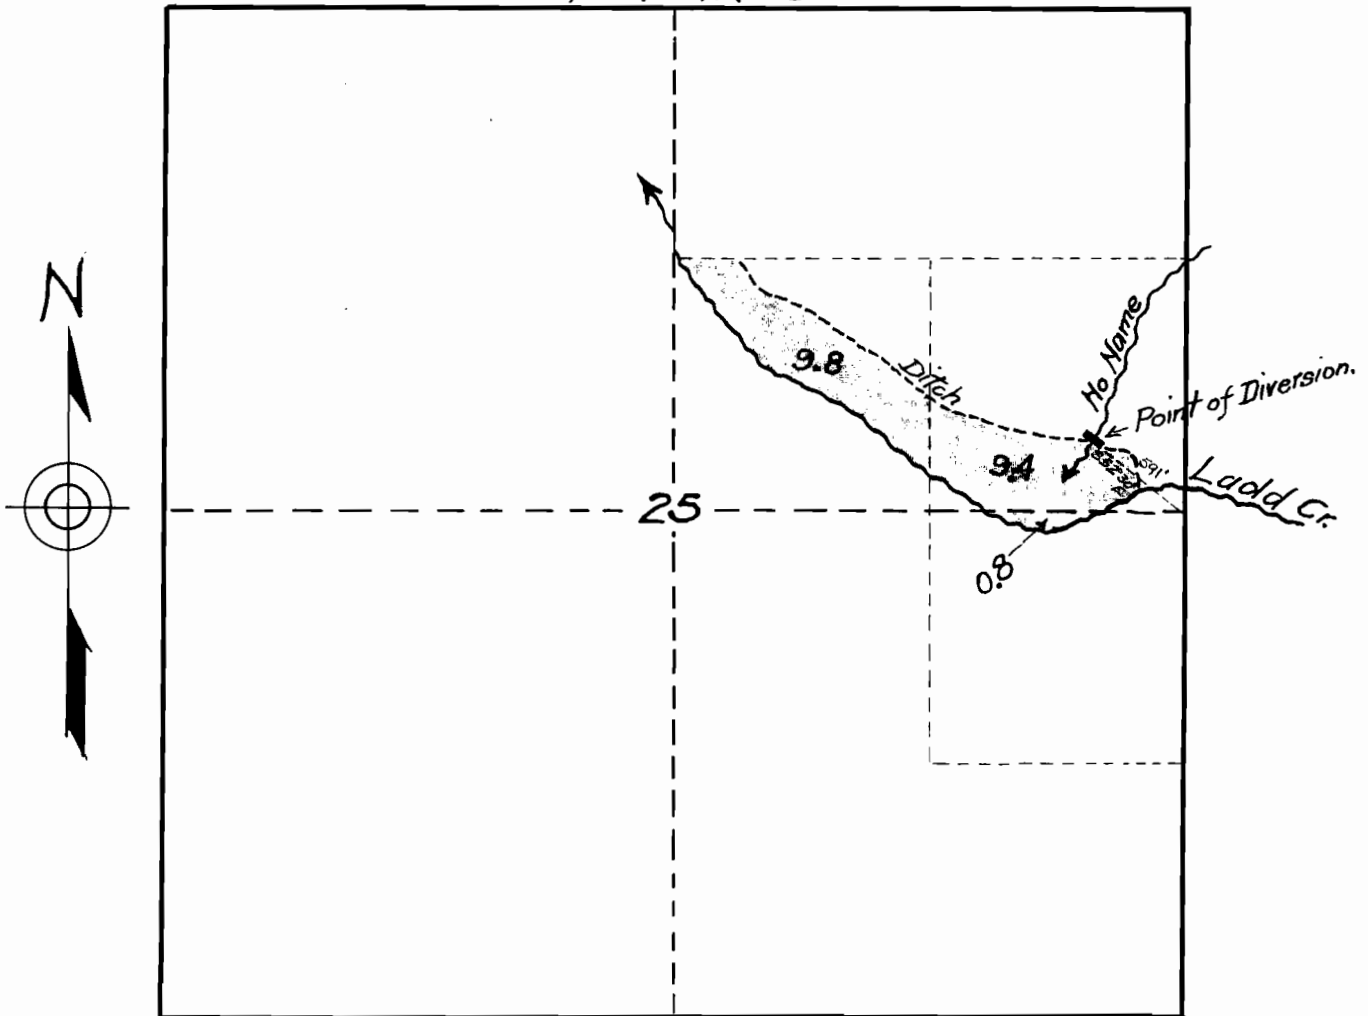

No Dam needed account of slope of ground.

Scale 1"=1000'

17071

Jan 14, 1929.