


T.12S.R.6W.W.M.

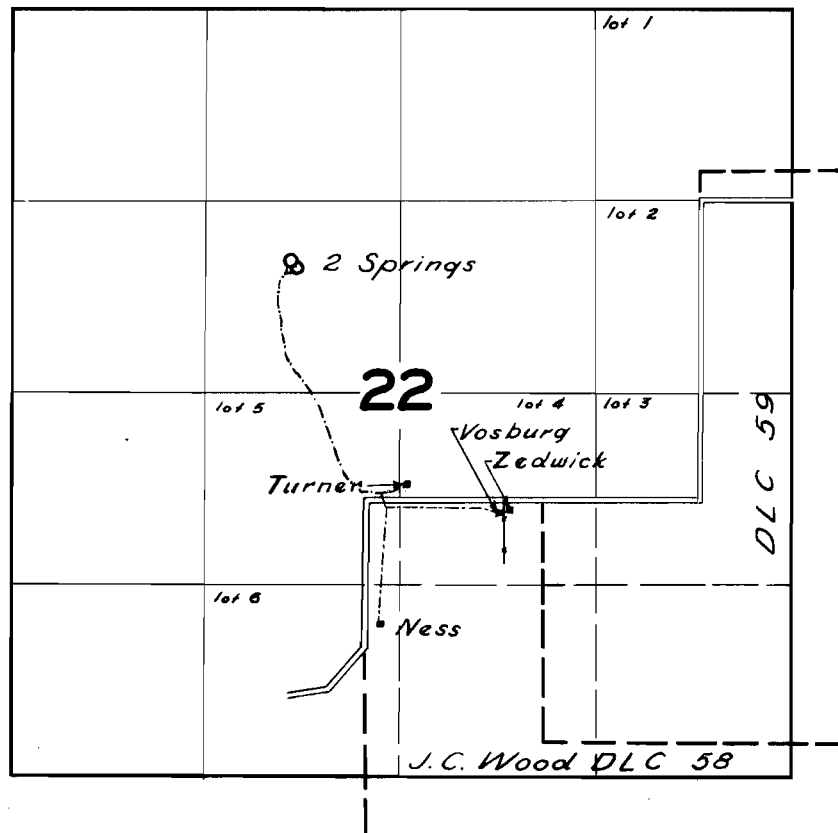

FINAL PROOF SURVEY
UNDER

Application No. 20423 Permit No. 15947
IN NAME OF

HENRY M. NESS

Surveyed 19 Aug. 1957, by C. A. Kelly