


T. 12 S., R. 6 W., W.M.

Section 22

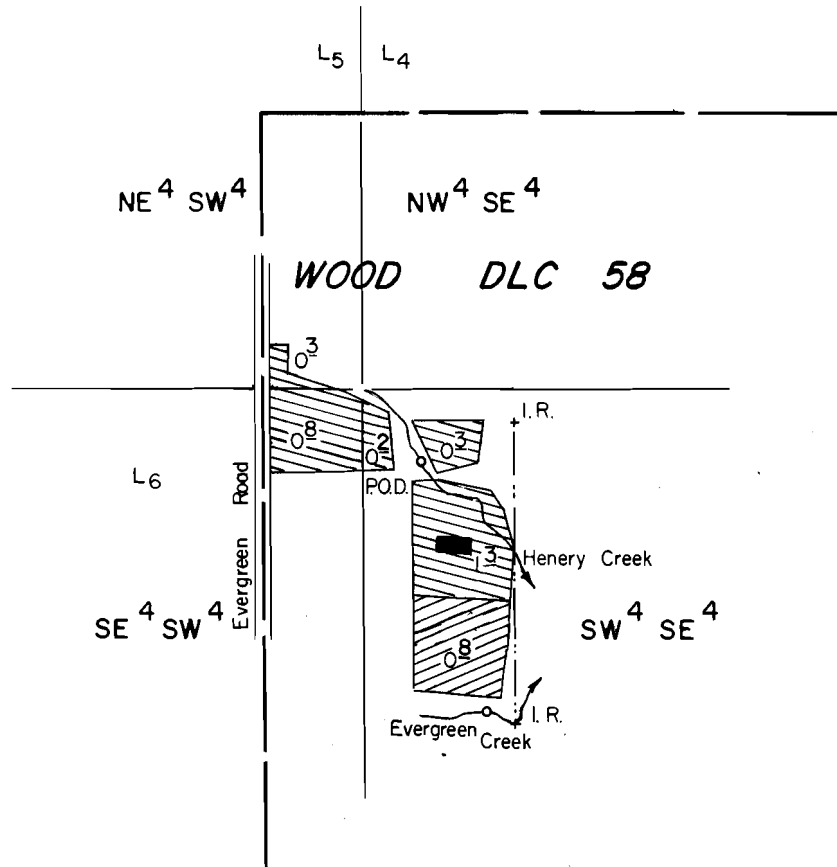

Henery Creek P.O.D.-730' S. & 330' E.

Evergreen Creek P.O.D.-1240' S. & 470' E., both from NW Cor. DLC 58.

Scale: 1" = 400'

From Henery Creek

From Evergreen Creek



FINAL PROOF SURVEY

UNDER

Application No. 63746... Permit No. 46997.....

IN NAME OF

RICHARD K. &/or NANCY J. RALEIGH

Surveyed AUG...14... 1987., by T. Warren.....