

**FINAL PROOF MAP
OF PERMIT G13266
FOR GERALD RIPKA
SEC'S. 34 AND 35, T1N, R23E WM
MORROW COUNTY, OREGON**

RECEIVED

OCT 22 1999

WATER RESOURCES DEPT.
SALEM, OREGON


AREAS IRRIGATED BY



1/4 MILE
WHEEL LINE




BIG GUN
3-0.60"
NELSON NOZZLE

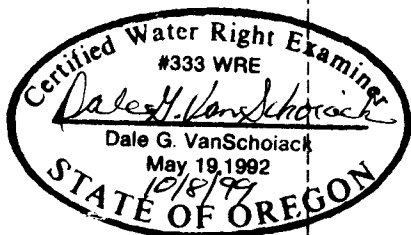

5" PORTABLE

5" PORTABLE

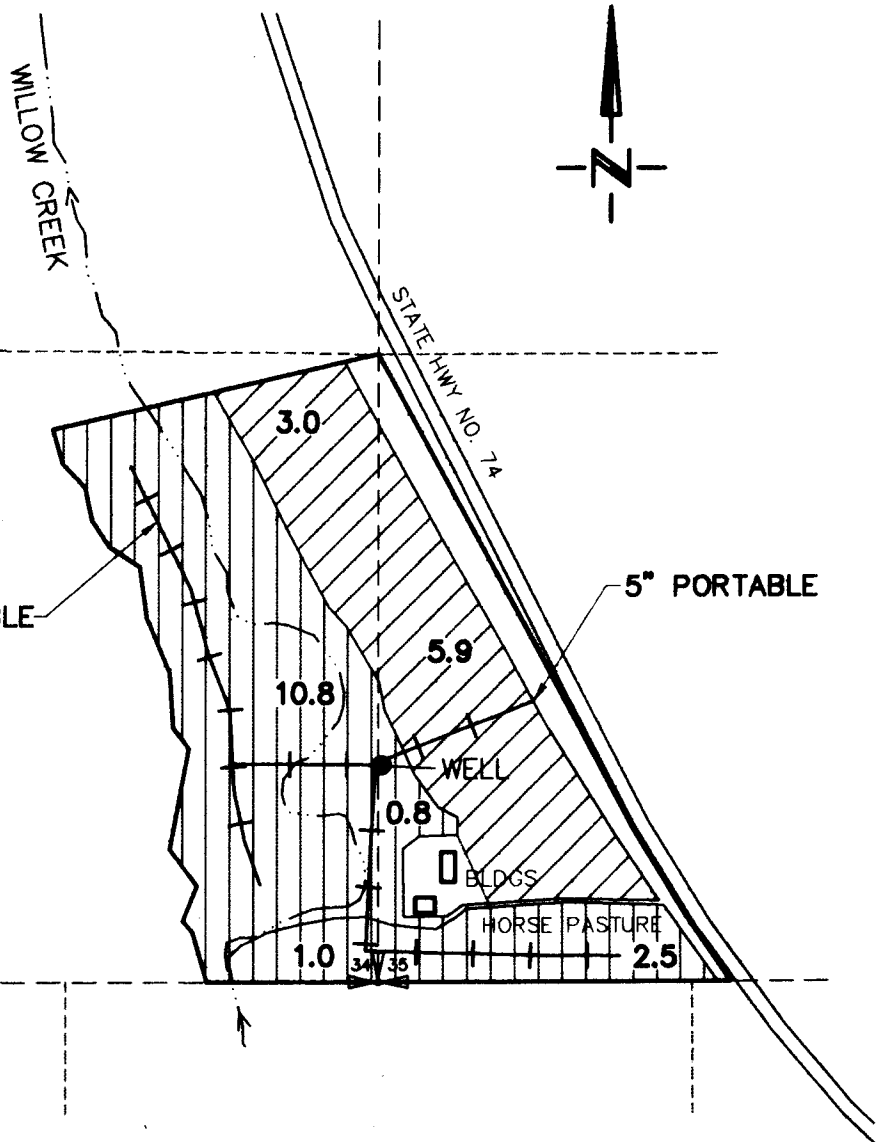

POINT OF APPROPRIATION
WELL LOCATION 450' NORTH
AND 10' EAST OF THE
SW COR SEC 35

0 400 800
SCALE IN FEET

NOTE:

THE PURPOSE OF THIS MAP IS TO IDENTIFY THE APPROXIMATE LOCATION OF THE WATER RIGHT. IT IS NOT INTENDED TO PROVIDE INFORMATION RELATIVE TO THE LOCATION OF PROPERTY OWNERSHIP BOUNDARY LINES.