



RECEIVED

MAY 03 2000

WATER RESOURCES DEPT
SALEM, OREGON**FINAL PROOF SURVEY MAP
IN THE NAME OF GARY WEISS**

APPLICATION S-71752 PERMIT 52754

SECTION 30, TOWNSHIP 28 SOUTH, RANGE 4 WEST, W.M.

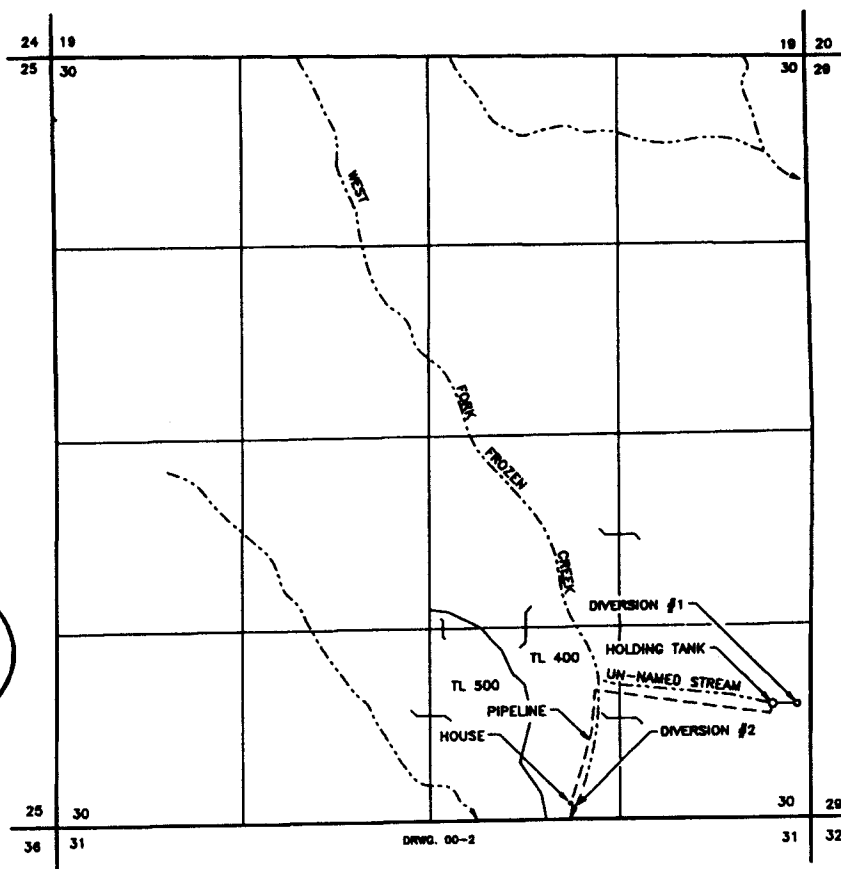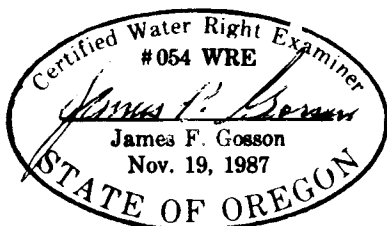

Diversion #1 (from an un-named stream) is located 770 feet north and 100 feet west from the southeast corner of Section 30, being within the SE 1/4 SE 1/4 of Section 30. Diversion #2 (from West Fork Frozen Creek) is located 70 feet north and 1650 feet west from the southeast corner of Section 30, being within the SW1/4 SE1/4 of Section 30; both being within Section 30, Township 28 South, Range 4 West, W.M., Douglas County, Oregon.

The purpose of this map is to identify the location of the water right. It is not intended to provide information relative to the location of property ownership boundary lines.

PC