
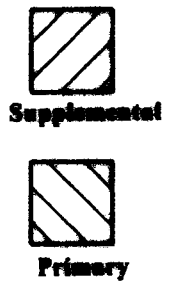


RECEIVED

DEC 14 1999

STATE OF OREGON
DEPARTMENT OF GEOLOGY

T.6S. R.1W., W.M

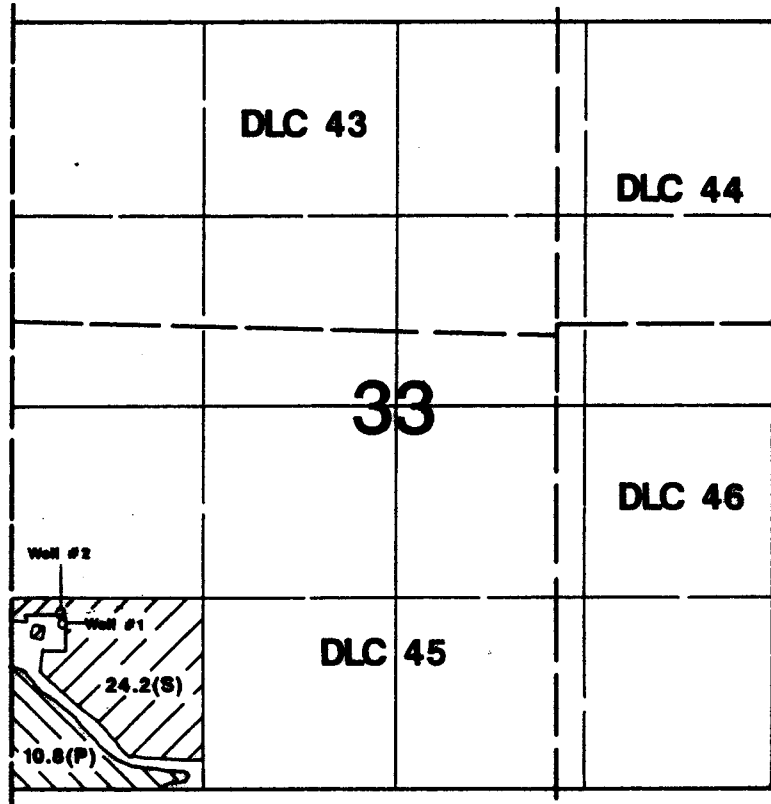

Well #1 is located 1120'N & 360'E from the SW corner of Section 33.
 Well #2 is located 1180'N & 350'E from the SW corner of Section 33

Final Proof Survey

Application #: G-14355 Permit #: G-13148

In Name Of

David & Rebecca Campbell

Surveyed on September 14, 1999 by JM Schuette

This Map Was Prepared For The Purpose Of Identifying The Location Of A Water Right Only And Is Not Intended To Provide Legal Dimensions Or Location Of Property Ownership Lines.

