


T.10 & 11 S. R. 46 E. W.M.

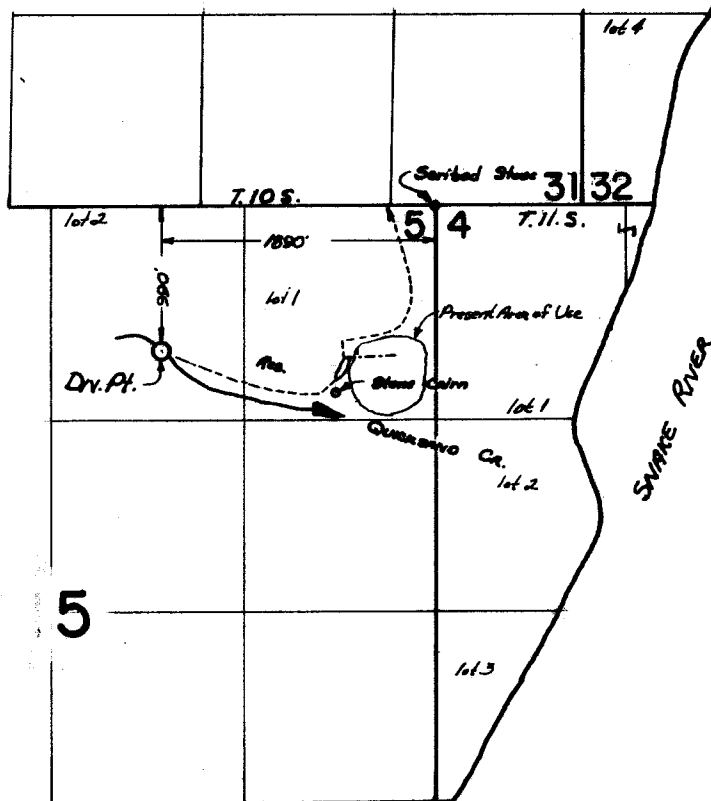

FINAL PROOF SURVEY
UNDER

Application No. _____ TRANSFER O 30
Permit No. _____
IN NAME OF
FRANS J. OLSON
Surveyed 21 OCT. 1969, by L. E. GOULD