


T. 9S., R. 3E., W.M.

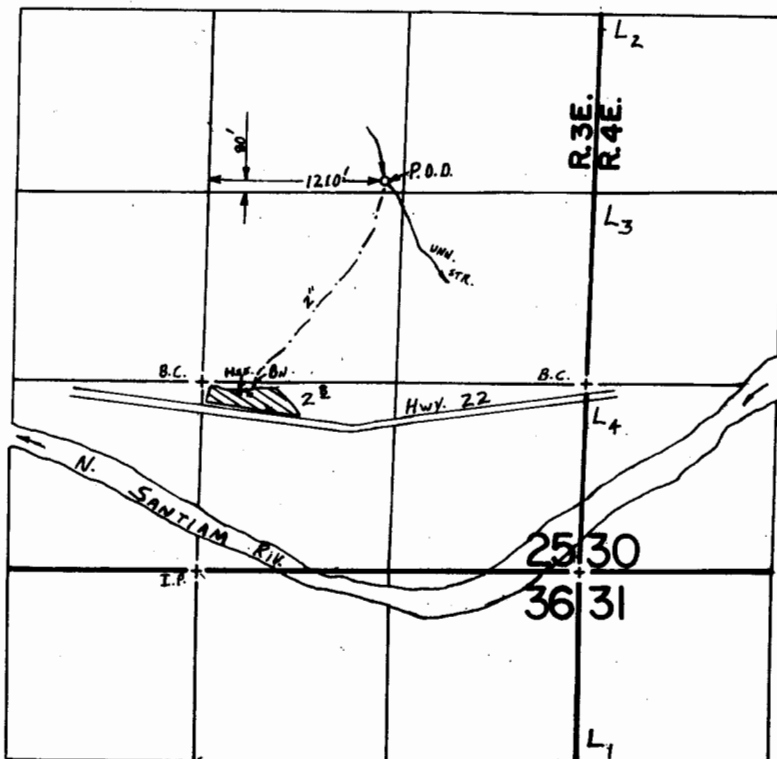

Scale: 1" = 1320'

FINAL PROOF SURVEY
UNDER

Application No. 55607... Permit No. 41665.....
IN NAME OF

.....*Hollis Gene Nelson*.....

Surveyed April 26.. 1985.. by ..P. Paster.....
Sept. 29. 1986, by T. Warren

41047-278-117 R
12/30/86 TAW