


T.6 S., R.1 W., W.M.

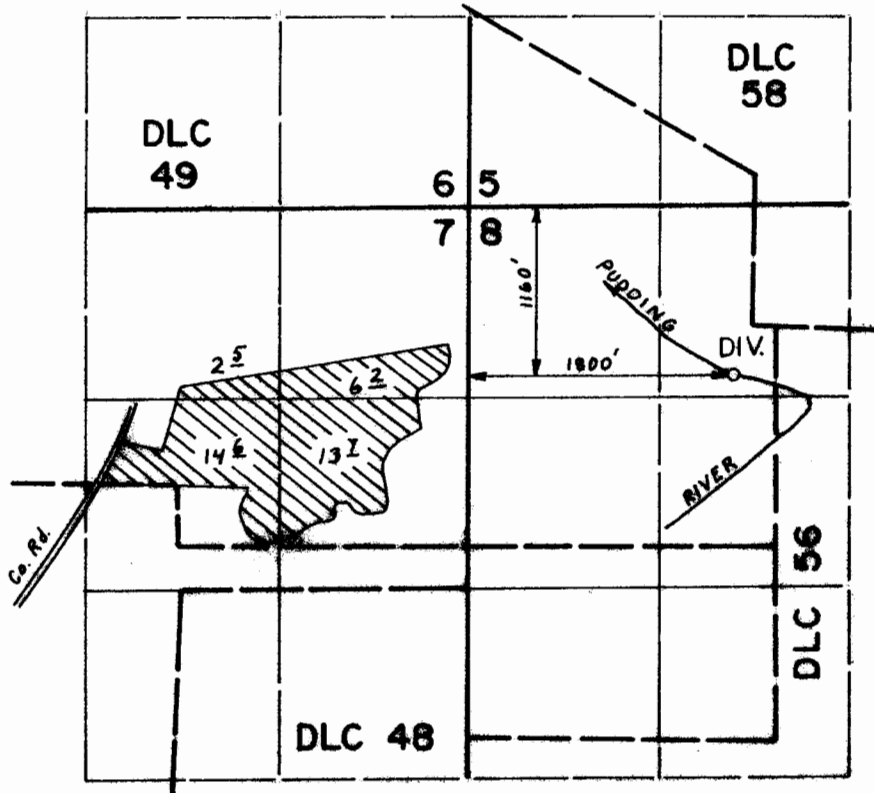

SCALE: 4" = 1 mile

FINAL PROOF SURVEY
UNDER

Application No. 63438. Permit No. 45779.....
IN NAME OF

.....**MELVIN KAUFMAN**.....

Surveyed SEPT. 1, 1984, by B. BISHOP.....