


T 7 S, R 4 W, WM

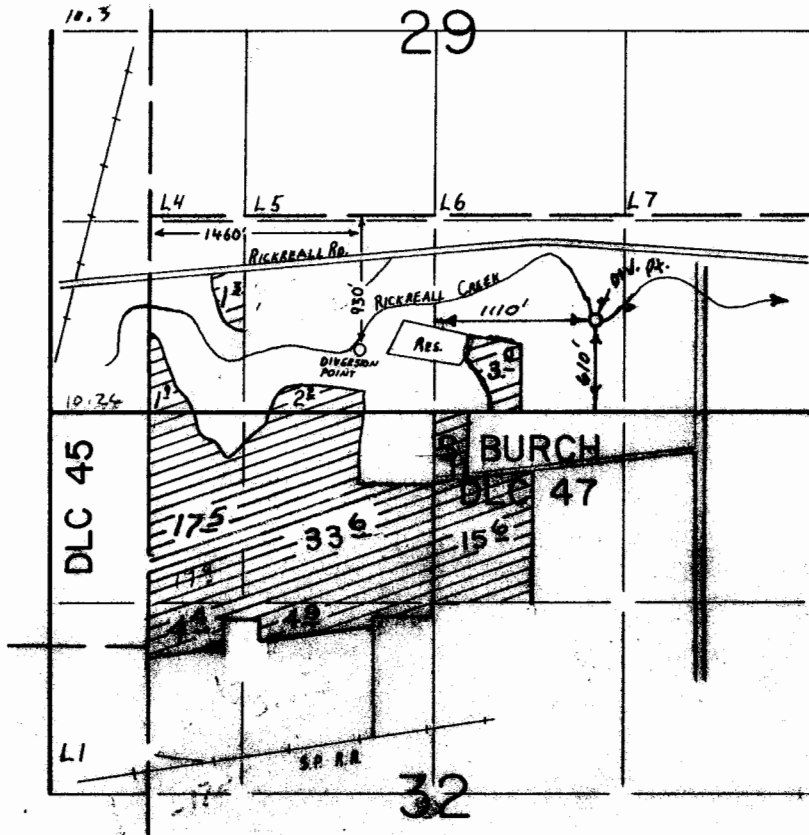

FINAL PROOF SURVEY
UNDER

R-67769 *R-9309*
Application No. *67770* Permit No. *48216*.....
IN NAME OF

ELMER STOLLER

Surveyed **APRIL 7 1988**, by **T. M. WARREN**.
OCTOBER 16 1992 by R. W. Hansen
September 6, 2001 by S. Brown

Revised 8-12-03