


T 7 S, R 4 W, WM

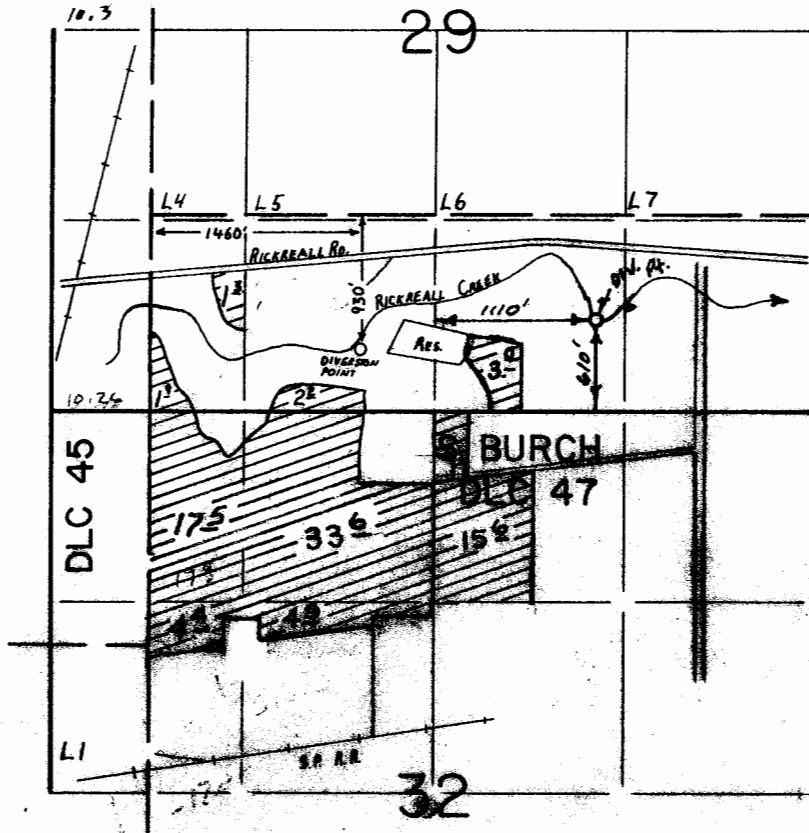

FINAL PROOF SURVEY
UNDER

R-67769 R-9309
Application No. 67770 Permit No. 48216.....
IN NAME OF

ELMER STOLLER

September 6, 2001 by S. Brown

Revised 8-12-03