


T. 7 S., R. 15 E., W.M.

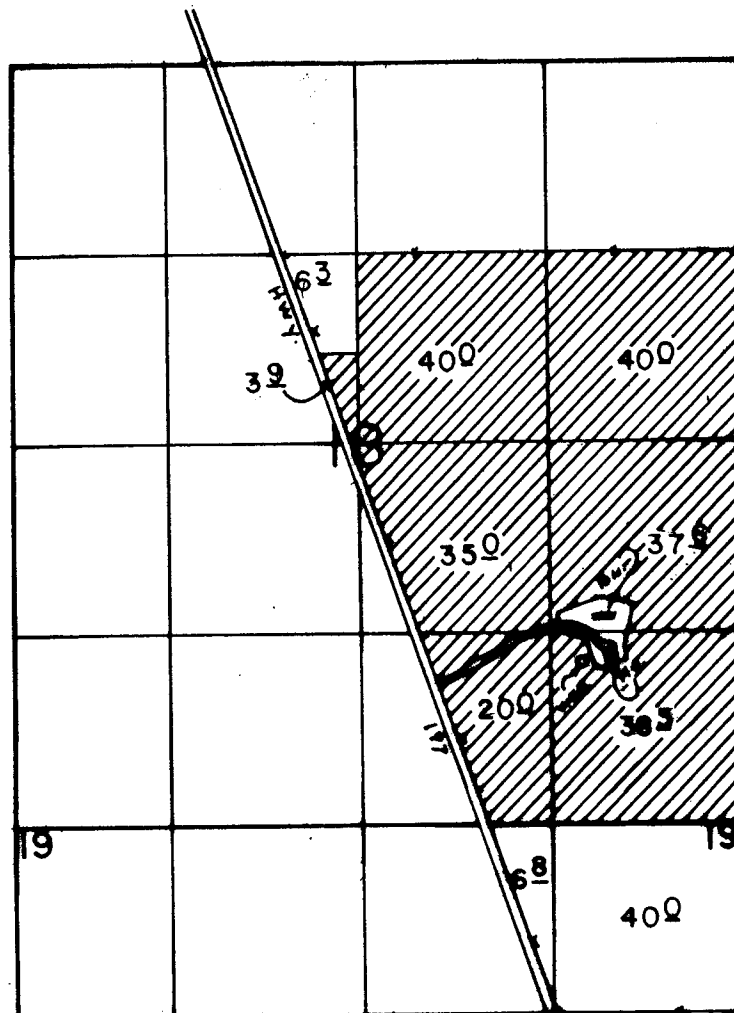

WELL LOC: 1150' N. & 1100' W. FROM SE COR. OF SEC. 18.

SCALE: 1" = 1320'

**FINAL PROOF SURVEY
UNDER**

Application No. G-10590 Permit No. G-9750
IN NAME OF
GEORGE W. SWAN

Surveyed JULY 21, 19 95, by R.M. SUTTERFIELD