


EXHIBIT "C"

FINAL PROOF MAP

APPLICATION NO. G-13194 PERMIT NO. G 11682
IN THE NAME OF CHARLES & FEGGY PAYTON

T 8 S, R 39 E, WM


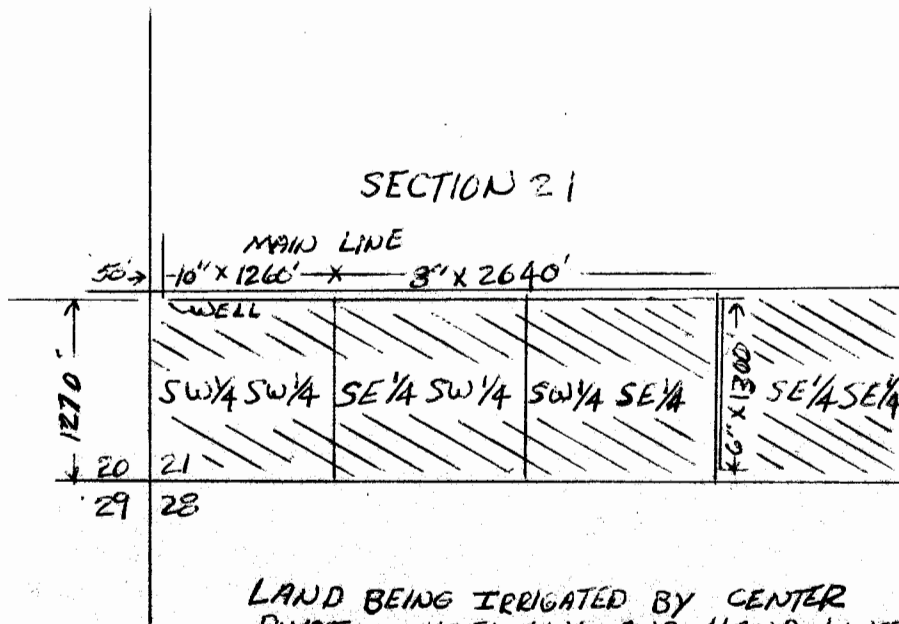

SCALE 4" = 1 MILE
SURVEYED 9-2-97
DRAWN 9-4-97 BY TAIK

