

61

FERRY
WILHEART ST
VIRGIL ST
VIRGIL ST

PARKER ST

CLOVERDALE

BIG

COUNTY


TAS

6 AC




FROM
OPEN 1

HORN CREEK
WEG SUPPLY
Permit # 36881, 2.0 CFS

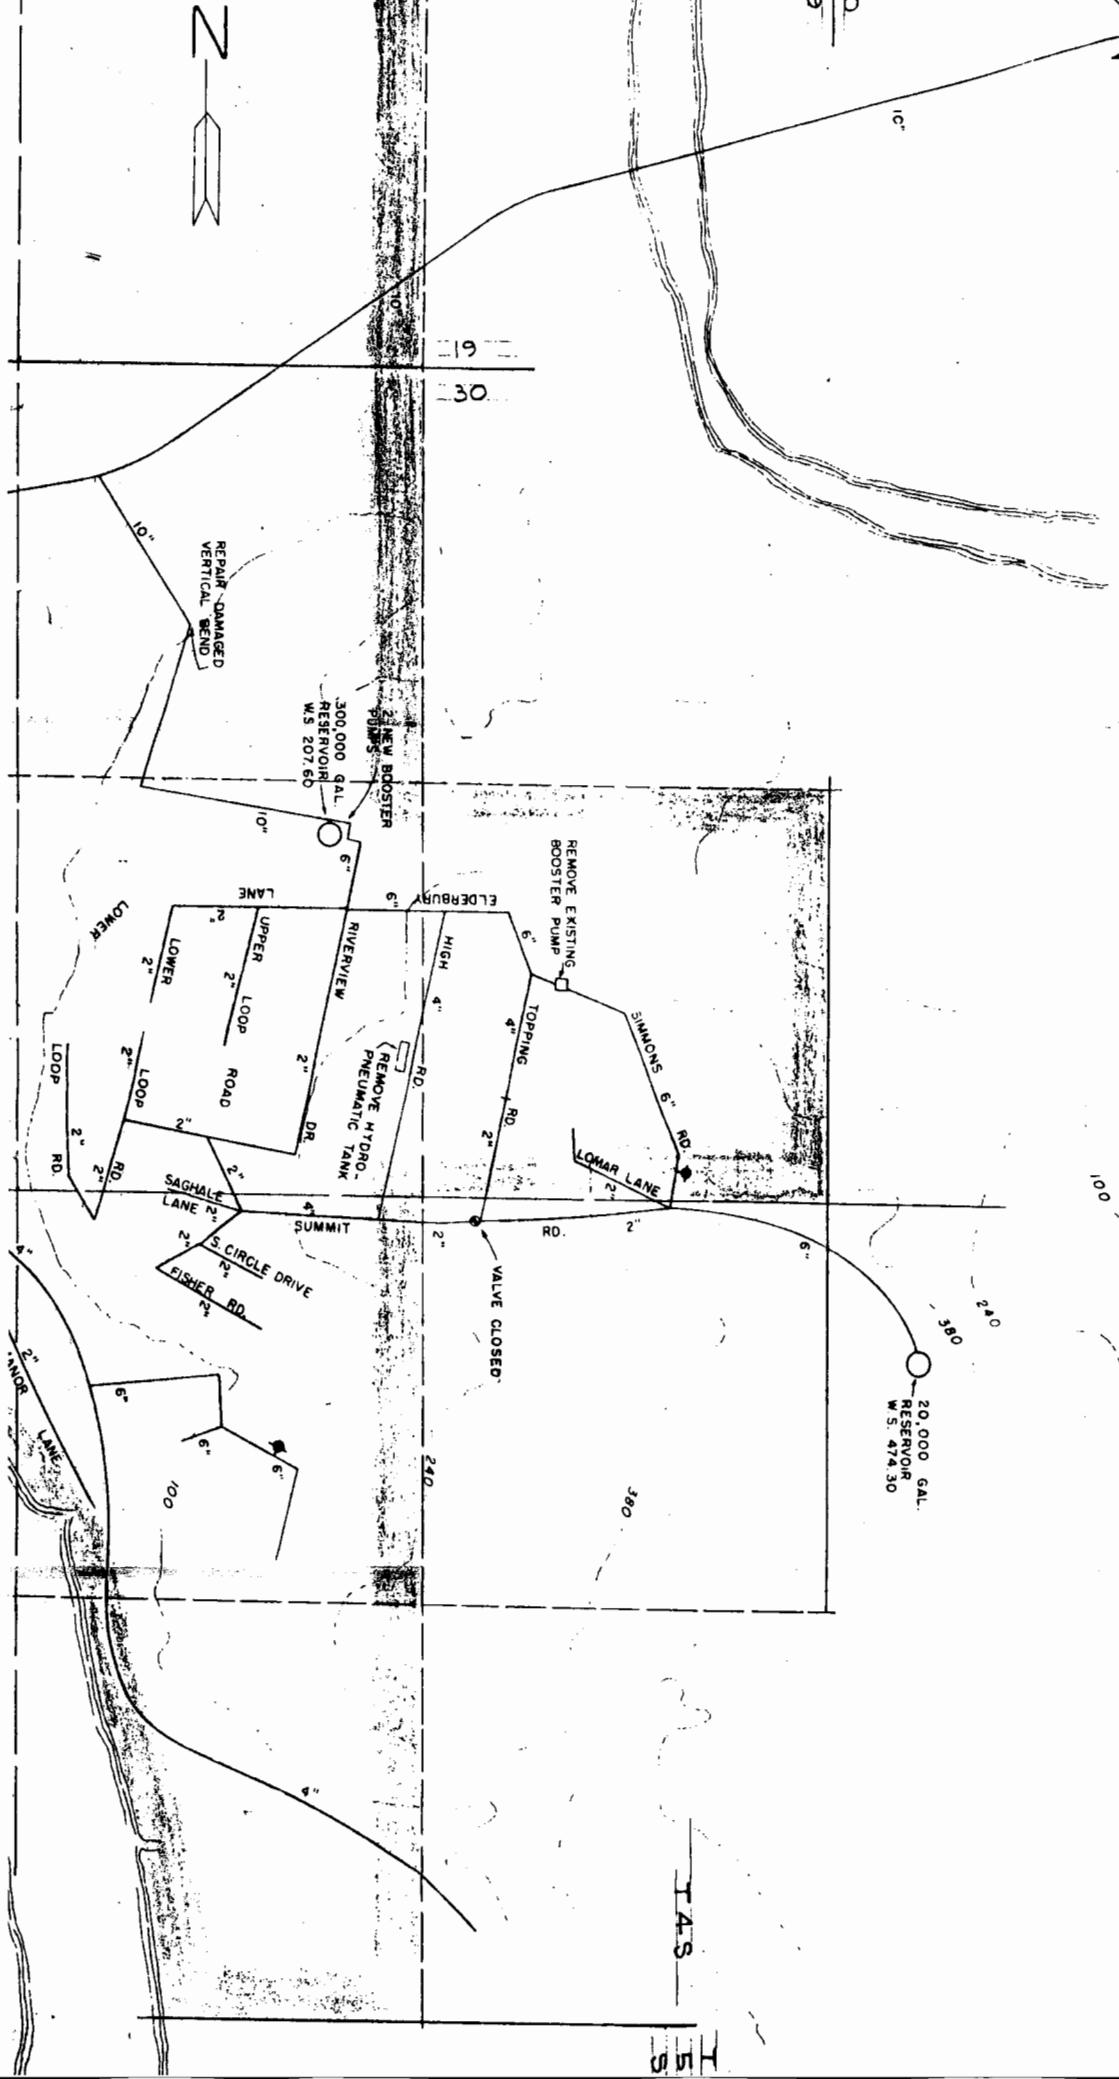

T.A.S.

T.S.S.

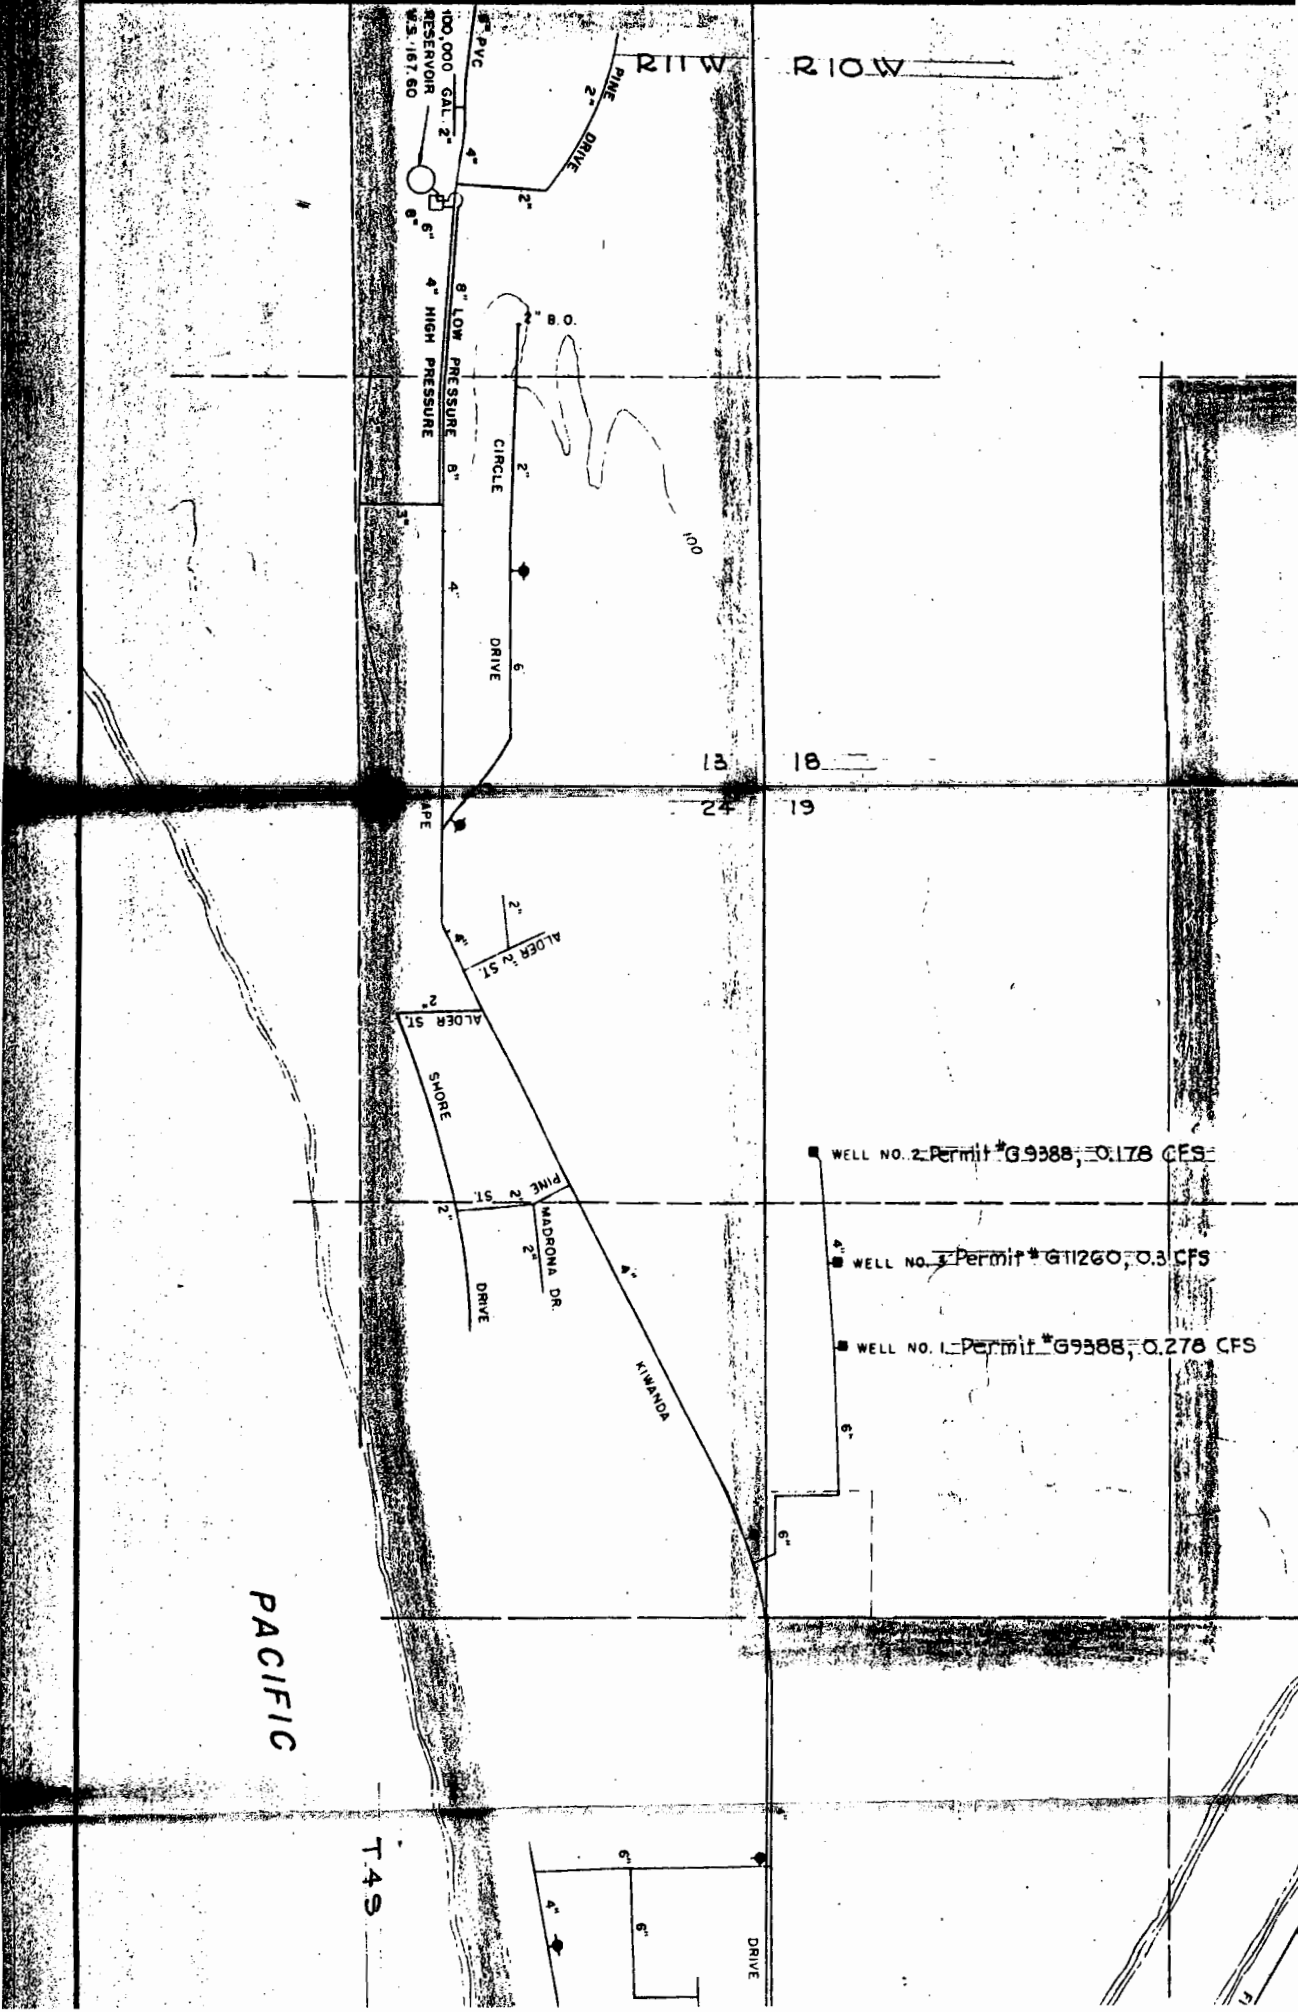

- WELL NO. 2 Permit # G9388; 0.178 CFS
- WELL NO. 3 Permit # G11260; 0.3 CFS
- WELL NO. 1 Permit # G9388; 0.278 CFS

PACIFIC

T49

13 18
24 19

DRIVE

SCALE: 1 inch = 400 feet

OCEAN

Permit No. 8-11754

WATER DIVISION



PACIFIC CITY WATER DISTRICT, OREGO


EXISTING WATER STORAGE & DISTRIBUTION SYSTEM SHOWING PROPOSED WELLS #4 & #5

SCALE: 1"=400'

JOHN W. CUNNINGHAM & ASSOCIATES

DATE	NO.	BY	REVISIONS
11-11-81	3	HSB	4
4-4-83	2	JHC	
4-23-81	1	JHC	

DESIGN	DATE	NO.	BY
R.S.	JAN	1	1981
J.C.	OP	1	

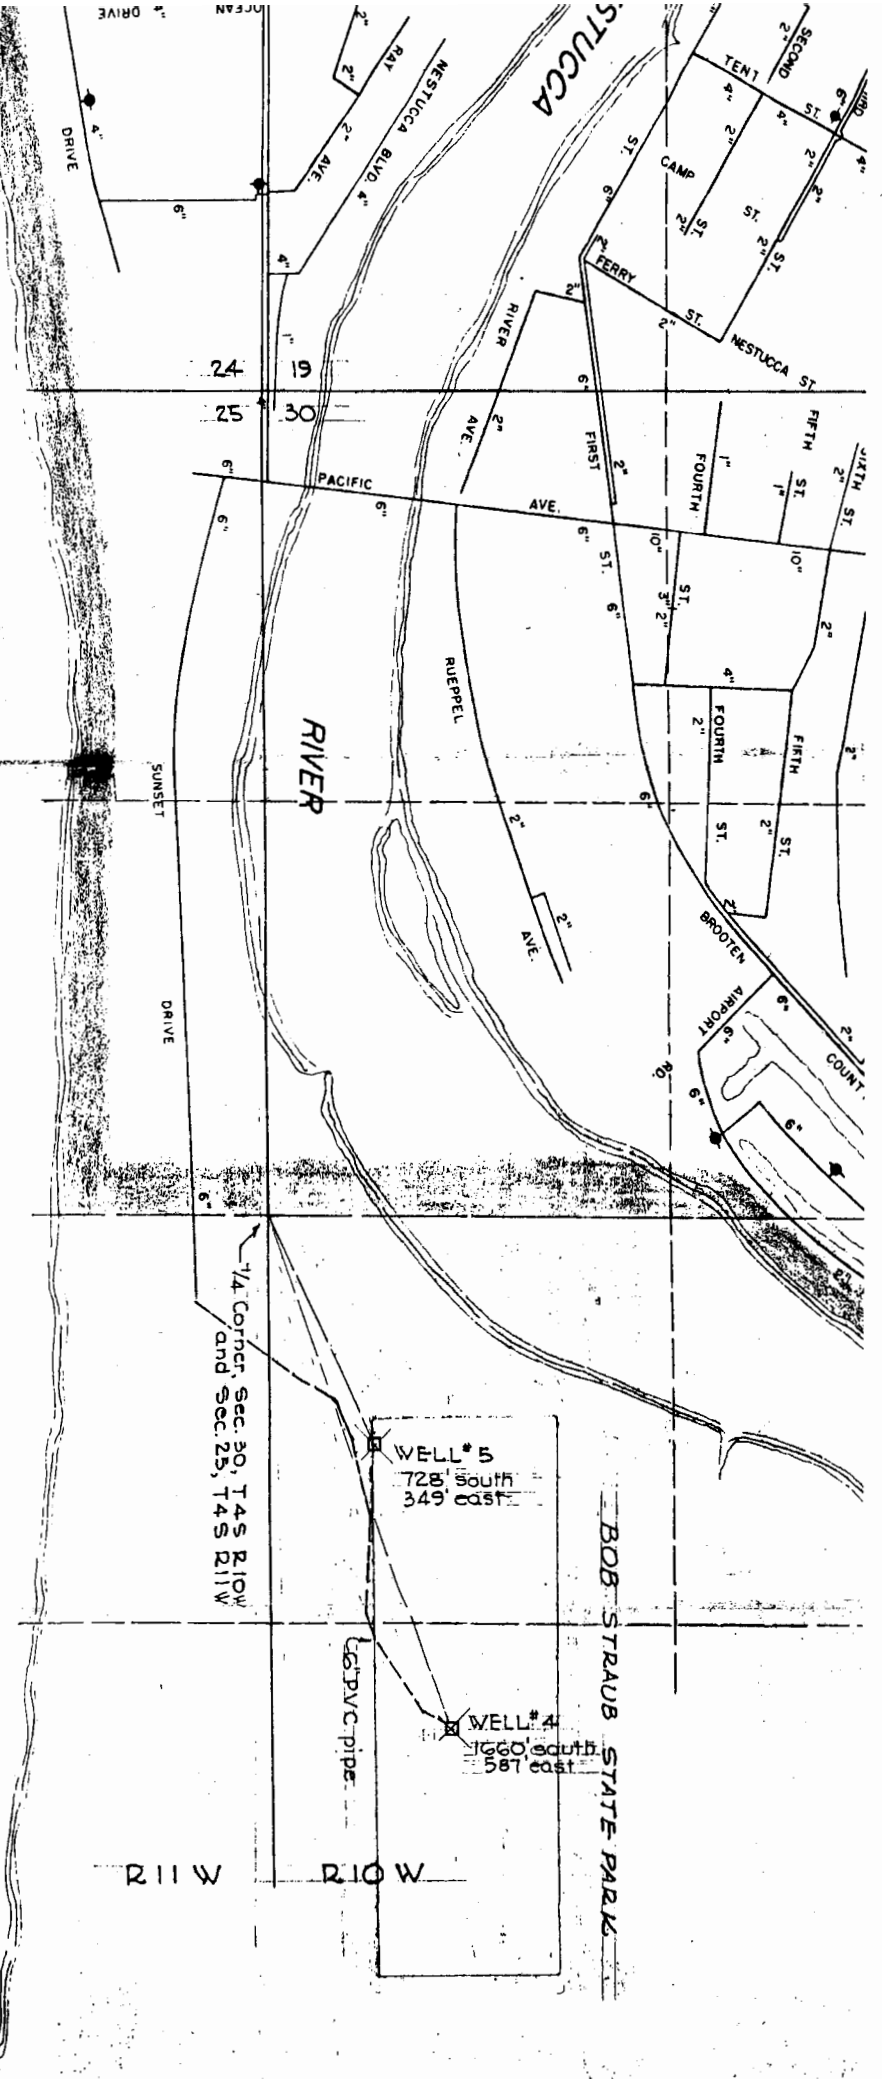

NOTE: This plan is for the purpose of identifying the location of water rights, only and has not been prepared to provide dimensions or location of property ownership lines.

1/4 Corner, Sec. 30, T4S R11W and Sec. 25, T4S R11W

BOB STRAUB STATE PARK

12\"/>

R11W R10W