


MSA

T.8S. R.38 E. W.M.

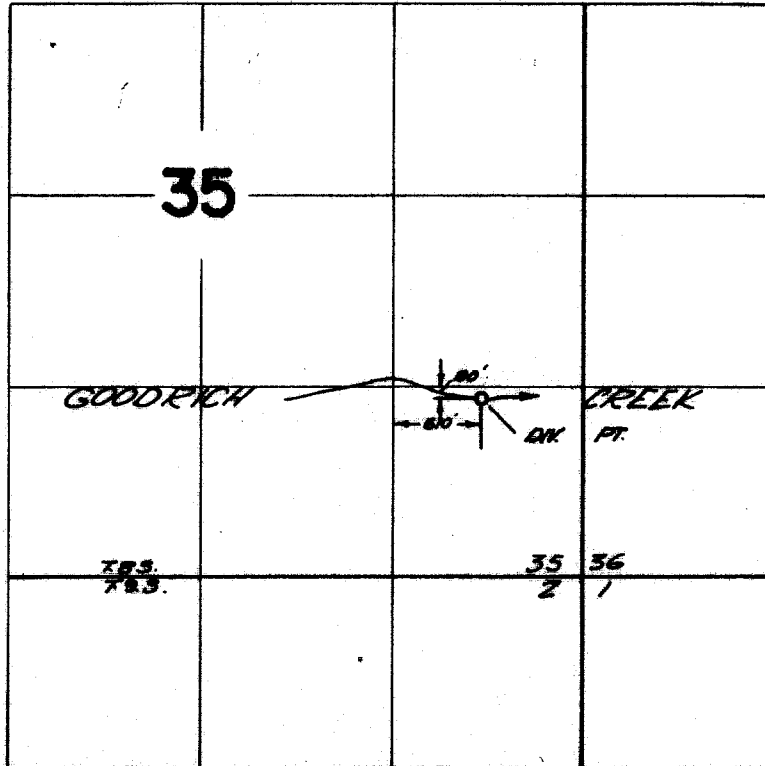

FINAL PROOF SURVEY UNDER

TRANSFER B-125

Application No. Permit No.

IN NAME OF

..... CITY OF BAKER

Surveyed Oct 25 1967, by V. Garner