

OFFICE OF STATE ENGINEER

ENGINEER

NOV 13 JL

SALT . OR


5281

1822

Application No. 1822

Permit No. 952

375.2W.

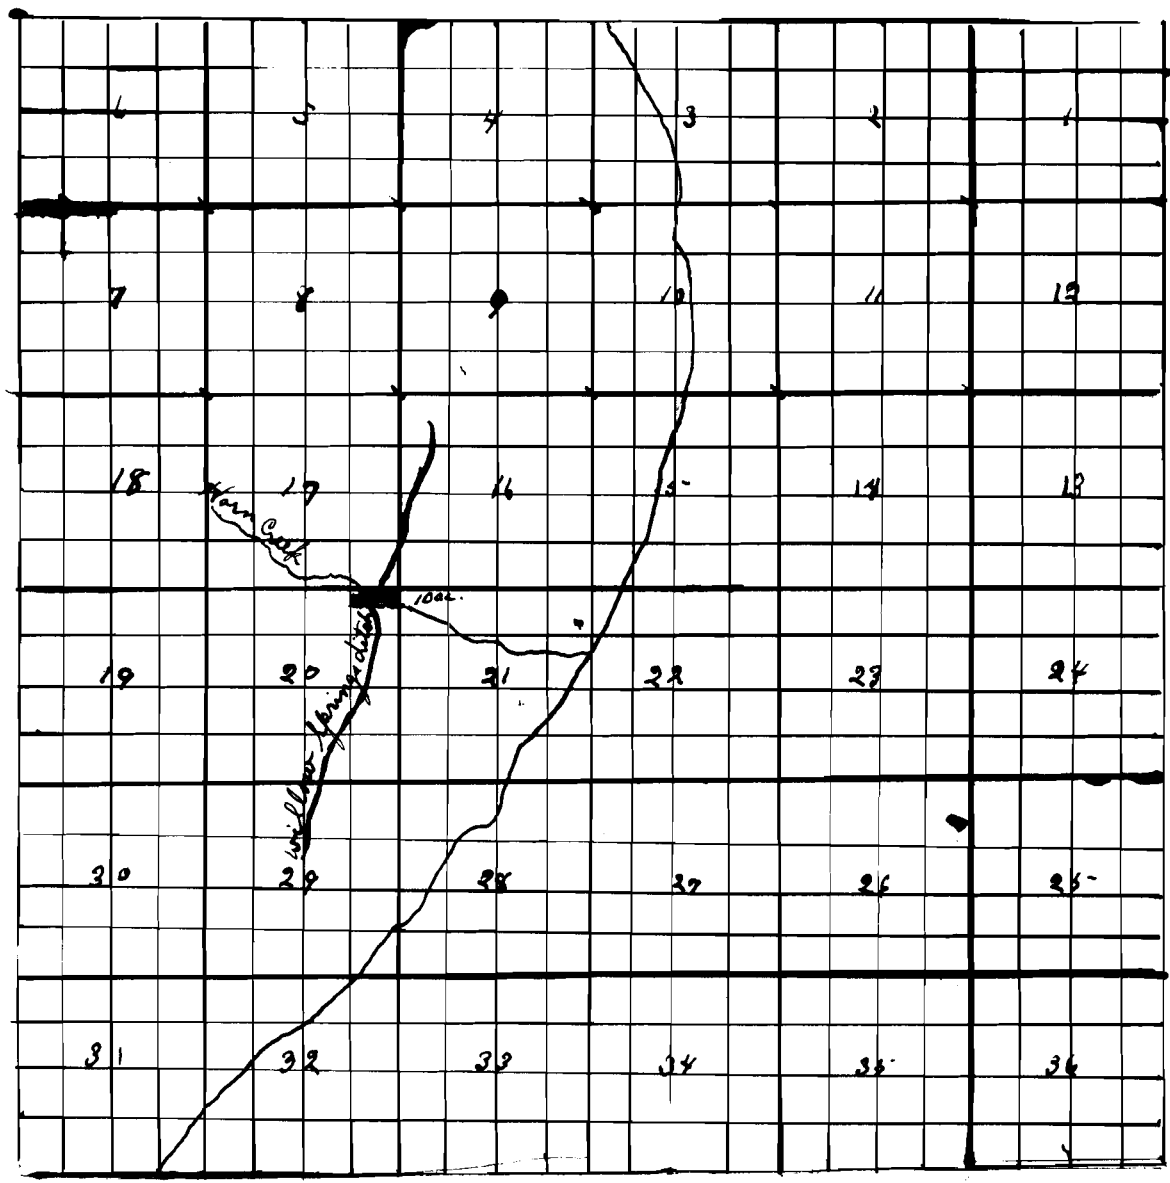

1825

1825

1852