


T13 S. R. 28 E. W. M.

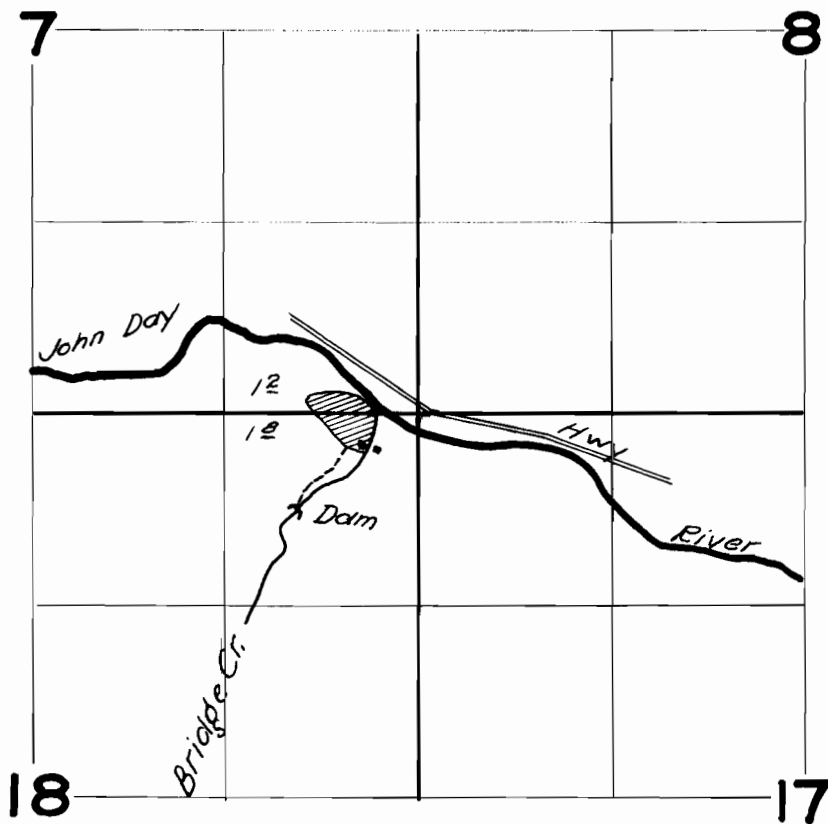

FINAL PROOF SURVEY

UNDER

Application No. 22451 Permit No. 17681

IN NAME OF

N. H. & J. L. Weaver

Surveyed Aug. 31 1954, by H. L. Coffman