
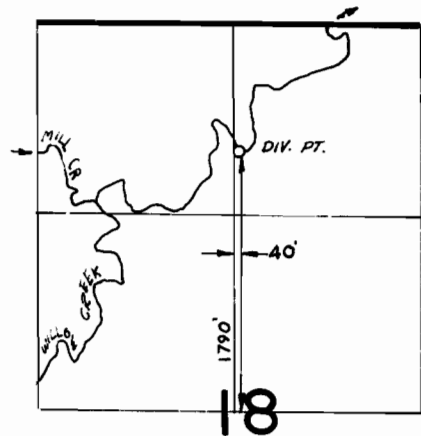


T. 15. R. 39E. W. M.

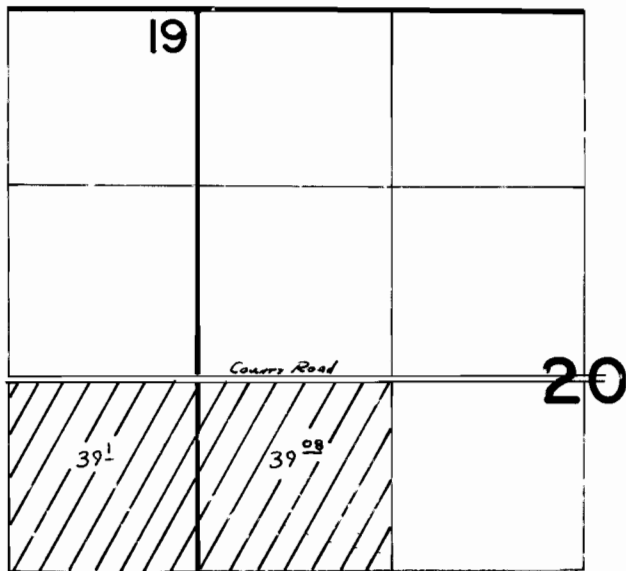

**FINAL PROOF SURVEY**  
UNDER

Application No. 53133 Permit No. 38610  
IN NAME OF

WILLIAM B. TEETER

Surveyed 8-27 1979, by J. Church