

CLAIM OF BENEFICIAL
USE MAP FOR BRADLEY
KLANN LOCATED IN SECTION
34, T.17S., R.17E., W.M.,
CROOK COUNTY, OREGON
W.O. 02-2496

RECEIVED

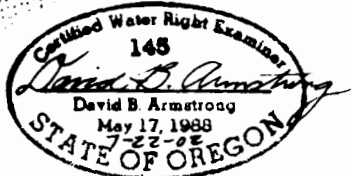
SEP 03 2002

WATER RESOURCES DEPT
SALEM, OREGONPREPARED FOR

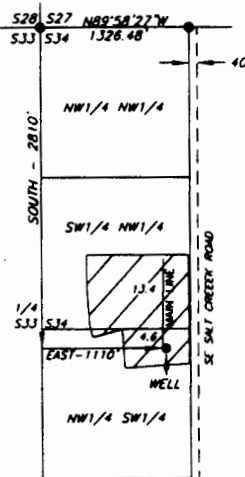
BRADLEY R. KLANN
1034 NW JUNIPER LN.
MADRAS, OR 97741
(541) 475-6919

PREPARED BY

ARMSTRONG SURVEYING
& ENGINEERING, INC.
378 NE SECOND STREET
(541) 447-7791

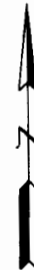


Renewal 12/31/03

LEGEND

PRIMARY
APPLICATION G - 14943
PERMIT G - 13745
PRIORITY MARCH 10, 1999

• FOUND 2-1/2" ALUMINUM CAP AS PER
CORNER FORM RECORDED DECEMBER 3,
2001 BY DAVID B. ARMSTRONG, LS 1026.

SCALE

1" = 1320'

660 0 660 1320

JULY 5, 2002

WELL LOCATION

MF 143335
NW1/4 SW1/4
2810' SOUTH & 1110' EAST
FROM NW COR. SECTION 34

SURVEY NOTE

THE PREPARATION OF THIS MAP IS FOR THE
PURPOSE OF IDENTIFYING THE LOCATION OF
THE WATER RIGHT ONLY AND HAS NO INTENT
TO PROVIDE DIMENSIONS OR LOCATIONS OF
PROPERTY OWNERSHIP LINES.

DRG. NO. 02-2496A

W.O. 02-2496