


T.4S.R.1W.



NOTE: SECTION CORNER APPROXIMATE. BASIS OF BEARING REFERENCED FROM EXISTING WATER SYSTEM MAP (FIG. 1) AND PROPERTY DESCRIPTION SUBMITTED TO STATE ENGINEER (EXHIBIT "C").

LAKEWOOD UTILITY, LTD SERVICE AREA (112 SERVICES)

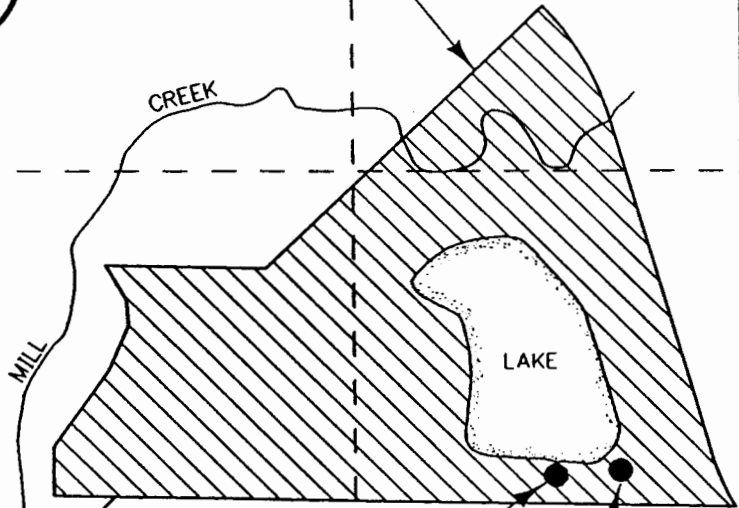


22 23  
27 26

WELL NO. 1  
BACK-UP WELL  
N. 74°32' E. 2037'  
OF DLC NO. 52

WELL NO. 2  
PRODUCTION WELL  
N. 75°37' E. 2254'  
OF DLC NO. 52

ANGLE CORNER  
J. KESTER  
DLC NO. 52

THIS MAP IS FOR THE PURPOSE OF IDENTIFYING THE LOCATION OF POINT(S) OF DIVERSION AND PLACE(S) OF USE OF THE WATER RIGHTS ONLY AND IS NOT INTENDED TO PROVIDE LEGAL DIMENSIONS OF THE PROPERTIES ILLUSTRATED HEREIN.

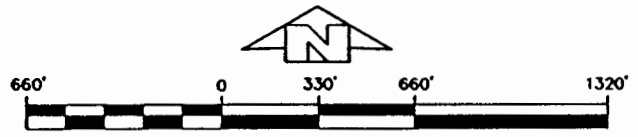

**FINAL PROOF SURVEY**  
UNDER

APPLICATION No. G-13469 PERMIT No. G-13092  
IN NAME OF

LAKEWOOD UTILITIES LTD.

SURVEYED APRIL 7, 1998 BY F. DUANE LEE P.E., C.W.R.E.

OWNER: <b>LAKEWOOD UTILITY, LTD.</b>	<b>LEE ENGINEERING, INC.</b> 1300 JOHN ADAMS ST. OREGON CITY, OR, 97045	
DWG TITLE: <b>WELL LOCATIONS AND SERVICE AREA</b>	DATE: 5/18/93 FILE NO: 1360501	REVISED: <b>FIGURE 5</b>