


T. 4S., R. 28E., W.M.

MORROW COUNTY

SCALE 1" = 1320'

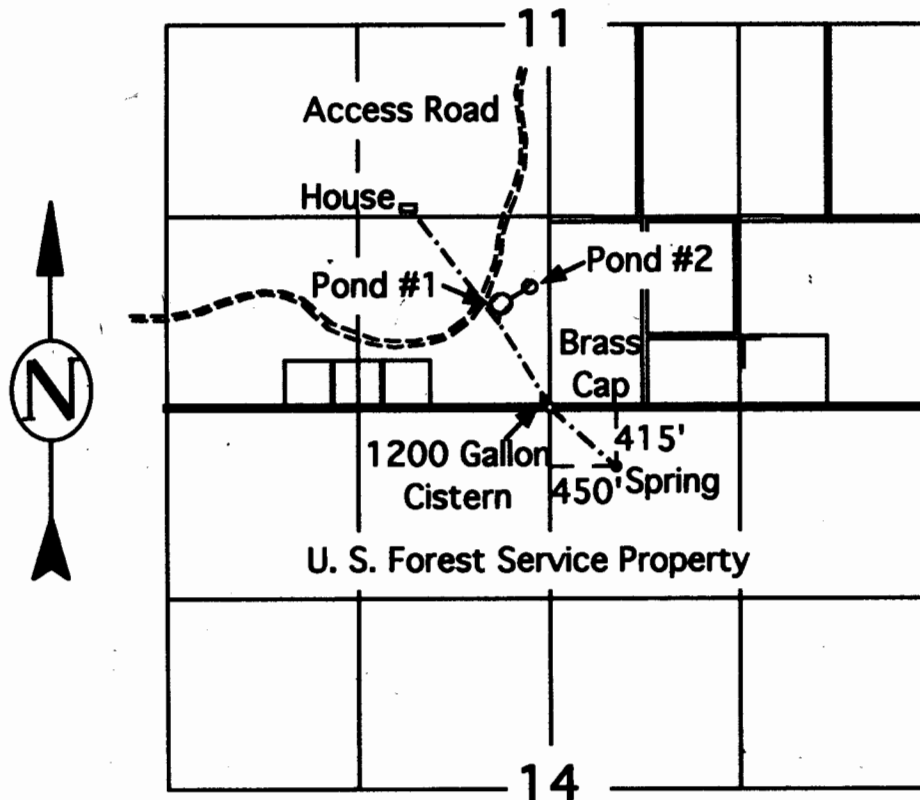

Application #S-72976
Permit # S-52022

Application #R-72975
Permit # R-11699

Spring Located 415 Ft. South & 450 Ft. East of North 1/4 Corner, Section 14

WATER RIGHTS PROOF MAP



Water Rights Found at This Location
IN NAME OF

Bruce Young

THIS MAP IS FOR THE PURPOSE
OF IDENTIFYING THE LOCATION
OF WATER RIGHTS ONLY AND IS
NOT INTENDED TO PROVIDE THE
LEGAL DIMENSIONS OR LOCATIONS
OF PROPERTY OWNERSHIP LINES.

ENGINEERING - LAND SURVEYING - WATER RIGHTS
R. V. McKINNIS ENGINEERING



79980 Prindle Loop Road
Hermiston, Oregon 97838
(541) -567-2017



RECEIVED

SEP 25 2000

WATER RESOURCES DEPT
SALEM, OREGON