


T. 4 S., R. 28 E., W.M.

RECEIVED

DEC 30 1994

W.D. RESOURCES DEP
SALEM, OREGON

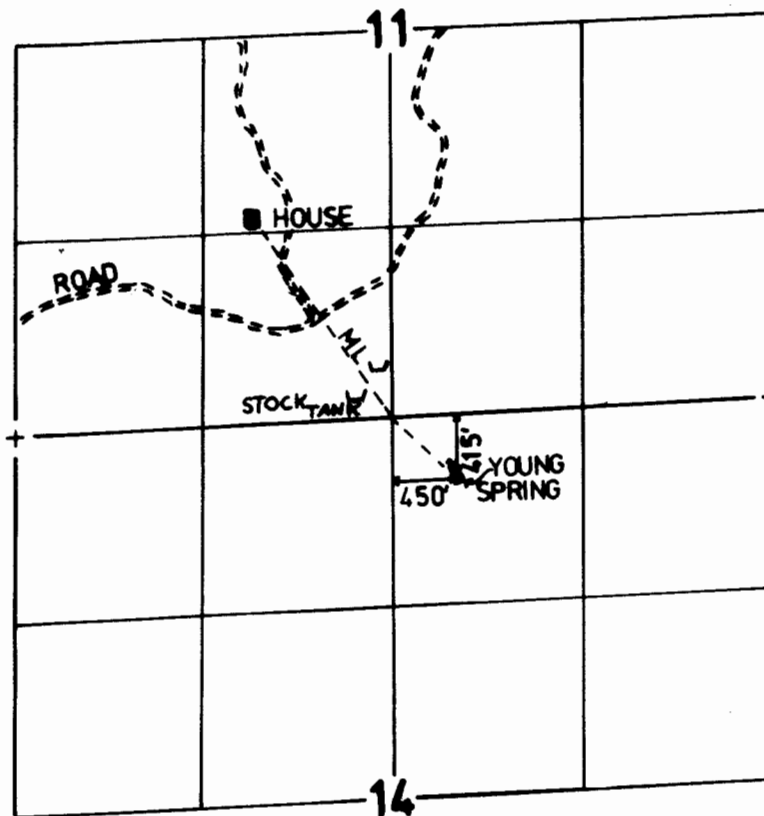

FINAL PROOF SURVEY
UNDER

Application No. 67299 Permit No. 51478
IN NAME OF

U.S. UMATILLA NATIONAL FOREST

Surveyed 9-10, 1993, by J. MILLER