

RECEIVED


SEP 30 1987

WATER RIGHTS DIVISION
SALE & RECORDS

FINAL PROOF SURVEY MAP IN THE NAME OF HARRY G. SPENCER

SECTIONS 11, 12, & 13, TOWNSHIP 30 SOUTH, RANGE 15 WEST, W.M.

APPLICATION G-12685 PERMIT G-11826

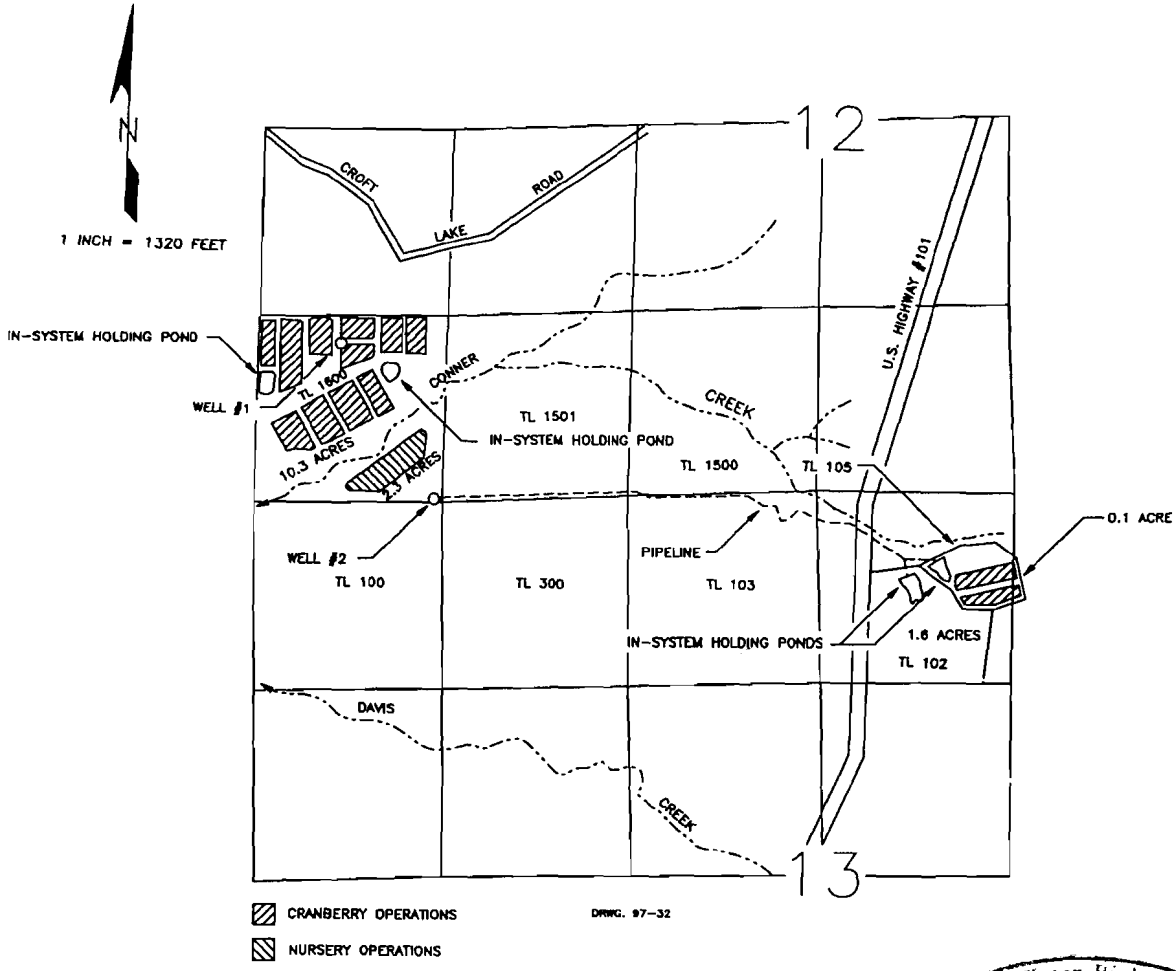

Certified Water Right Examiner
#054 WRE
James F. Gosson
James F. Gosson
Nov. 19, 1987
STATE OF OREGON

WELL # 1 IS LOCATED 1100 FEET NORTH AND 660 FEET WEST; WELL #2 IS LOCATED 5 FEET NORTH AND 20 FEET WEST, BOTH BEING FROM THE SOUTHEAST CORNER OF SECTION 11 AND BOTH BEING WITHIN THE SE1/4 SE1/4 OF SECTION 11, TOWNSHIP 30 SOUTH, RANGE 15 WEST, W.M., COOS COUNTY.

THE PURPOSE OF THIS MAP IS TO IDENTIFY THE LOCATION OF THE WATER RIGHT. IT IS NOT INTENDED TO PROVIDE INFORMATION RELATIVE TO PROPERTY OWNERSHIP BOUNDARY LINES.